

COVINGTON
 F 2000
 7-20-78

MISSISSIPPI
 BOARD OF WATER COMMISSIONERS
 416 North State Street
 Jackson, Mississippi 39201

WATER WELL DRILLERS LOG


7-20-78 date well completed
 Green Water Well Drilling firm name
 Covington county well located

LANDOWNER: John A. Clay
Route 4, Collins
 (mailing address)
 WELL LOCATION:
 sec. 2 T. 8 N R. 16 E
4 miles N of Collins
 (distance) (direction) (nearest town)

description of formations encountered	from	to
Red. Clay	0	10
White. Clay	10	20
" "	20	30
" "	30	40
" "	40	41
SAND	41	43
Blue Clay	43	50
" "	50	60
" "	60	70
" "	70	80
" "	80	90
" "	90	100
" "	100	110
" "	110	120
SAND	120	130
" "	130	140

WELL PURPOSE:
 (home, irrigation, municipal, industrial)
 WELL COMPLETION DATA:
 (1) diameter (inches) 4
 (2) total depth (feet) 140
 (3) static water level (feet) 58 below above top of ground.
 (4) casing PVC 130
 (material) (depth)
 (size) if telescope see back.
 (5) screen 7' 130
 (length) (depth to top)
3x.008 PVC
 (size) (material)
 (6) pump 1 10
 (HP) (yield gpm)
200 VAC
 (type power)
 (7) electric log NO
 (yes or no)
 (organization running log)
 (8) how well bottom plugged

DRILLERS REMARKS:

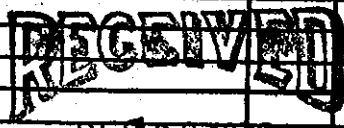

DEC 28 1978

MISS. BD. OF WATER COMM.