

COVINGTON MISSISSIPPI BOARD OF WATER COMMISSIONERS

G 15

WATER WELL DRILLERS LOG

1-23-61

Date: 1-23, 1961, Driller: Hermon PARKER, Covington County, MISSISSIPPI

(Name)

(1) Owner of Land: Gilles P. E. Terminal Co.
 (Name)
 Collins, Miss
 (Address)

(2) Location: 1/4, 1/4, Sec. 33, T. R.
 1 miles South of Collins
 (distance) (direction) (Nearest Town)

(3) Topography: Level
 (Hilly) (Flat) (Level)

(4) Purpose of Well: Domestic
 (Domestic Irrigation
 Municipal, Industrial, Other)

Description & Color of Materials
 Sand, Clay, Red Clay, Shell, etc.

Thick-
ness
Feet

Depth
Feet

Blue Chalk 105 105
 Sand 52 52

157 157

Information upon completion of well:

(1) Diameter 2 inches.

(2) Total Depth 157 feet.

(3) Water Level 32 feet below top of ground.

(4) Cased to 157, Size 2"


(5) Screen: Size 2", Length 5'

(6) Were any formations sealed against pollution?
 no

If YES depth of formation

Why

Drillers Remarks:

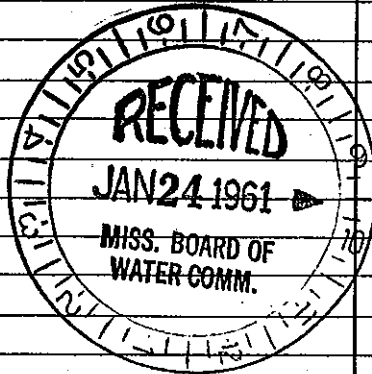

(Use Back Side)

Well No. 13

Mail this copy to Board of Water Commissioners 429 Miss. St. Jackson, Miss.