

COVINGTON MISSISSIPPI BOARD OF WATER COMMISSIONERS

G16

GULF OIL GAS

CODED

WATER WELL DRILLERS LOG

9-21-63

Date: 9-21-63, 1963, Driller: M. R. Donald Hill County Covington
Inc (Name)

(1) Owner of Land:	Description & Color of Materials Sand, Clay, Red Clay, Shell, etc.	Thick- ness Feet	Depth Feet
Miss Gulf Refining Co. (Name)	CLAY	0	10
Collins, Miss (Address)	SAND	10	41
(2) Location: 1/4, 1/4, Sec. 30 T. 8 R. 15, 1 miles S.E. of Collins. (distance) (direction) (Nearest Town)	CLAY	41	102
	SAND	102	285
(3) Topography: <input checked="" type="checkbox"/> (Hilly) <input type="checkbox"/> (Flat) <input type="checkbox"/> (Level)	SHALE	285	400
(4) Purpose of Well: Industrial (Domestic Irrigation, Municipal, Industrial, Other)	SAND	400	445

Information upon completion of well:


- (1) Diameter 4" inches.
- (2) Total Depth 445 feet.
- (3) Water Level 128' feet below top of ground.
- (4) Cased to 300', Size 4 1/2" O.D.
157', 2 1/2" O.D.
- (5) Screen: Size 2, Length 11'
- (6) Were any formations sealed against pollution?
_____ yes, _____ no.

CODED

If YES depth of formation _____

Why _____

Drillers Remarks: _____

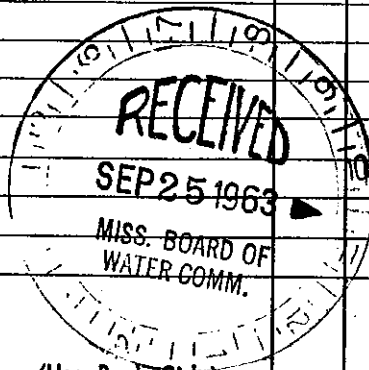

Well No.

(Use Back Side)

Mail this copy to Board of Water Commissioners 429 Miss. St. Jackson, Miss.