

COUNTING MISSISSIPPI BOARD OF WATER COMMISSIONERS

DELIVERY STATION 49 SOUTH

G17

WATER WELL DRILLERS LOG

**CODED**

9-23-63

Date: 9-23, 1963, Driller: McDONALD = HILL County

(Name)

(1) Owner of Land:	Description & Color of Materials Sand, Clay, Red Clay, Shell, etc.	Thick- ness Feet	Depth Feet
COLONIAL PIPELINE CO (Name)	CLAY	0	80
COLLINS MISS (Address)	SANDY CLAY	80	160
(2) Location: 1/4, 1/4, Sec. 30 T8 R15	SHALE	160	320
_____ miles _____ of _____ (distance) (direction) (Nearest Town)	SHALE ST SAND	380	414
(3) Topography: X (Hilly) (Flat) (Level)	LIME ROCK ST	414	425
(4) Purpose of Well: (Domestic Irrigation Municipal, Industrial, Other)	LOOSE SHALE	425	500
	SAND ST SHALE	500	526

Information upon completion of well:


- (1) Diameter 4" inches.
- (2) Total Depth 526' feet.
- (3) Water Level 31' feet below top of ground.
- (4) Cased to 315', Size 4"  
221 = 2 1/2" PIPE
- (5) Screen: Size 2 1/2", Length 10'  
21' 6" GROUTED IN
- (6) Were any formations sealed against pollution?  
\_\_\_\_\_ yes, X no.

If YES depth of formation \_\_\_\_\_

Why \_\_\_\_\_

Drillers Remarks: \_\_\_\_\_

**CODED**

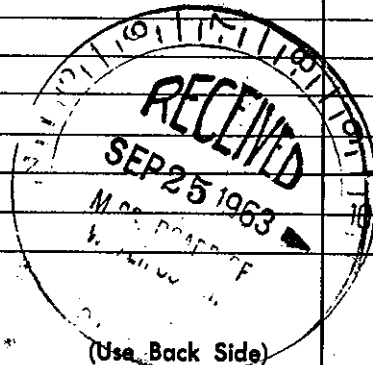

Well No. \_\_\_\_\_

Mail this copy to Board of Water Commissioners 429 Miss. St. Jackson, Miss