

COVINGTON MISSISSIPPI BOARD OF WATER COMMISSIONERS

518

COLONIAL MAIN STATION

WATER WELL DRILLERS LOG

CODED

9-12-63

Date: 9-12, 1963, Driller: M. C. Donald & Hill ^{Jr} County Covington

(Name)

(1) Owner of Land: Colonial pipe line
MAIN STATION
Collins, Miss.
(Address)

(2) Location: 1/4, 1/4, Sec. 20 T. 8 R. 15
miles of
(distance) (direction) (Nearest Town)

(3) Topography: (Hilly) (Flat) (Level)

(4) Purpose of Well: Industrial
(Domestic Irrigation
Municipal, Industrial, Other)


Description & Color of Materials Sand, Clay, Red Clay, Shell, etc.	Thick- ness Feet	Depth Feet
SANDY	0	20
SAND	20	62
CLAY	62	100
SAND	100	295
CLAY	295	340
SAND	340	370

Information upon completion of well:

- (1) Diameter 4" inches.
- (2) Total Depth 370' feet.
- (3) Water Level 135' feet below top of ground.
- (4) Cased to 315' 63', Size 4 1/2" O.D. 2 1/2" O.D.
- (5) Screen: Size _____, Length _____
21'-6" CEMENTED IN
- (6) Were any formations sealed against pollution?
_____ yes, _____ no.

CODED

If YES depth of formation _____
Why _____
Drillers Remarks: _____

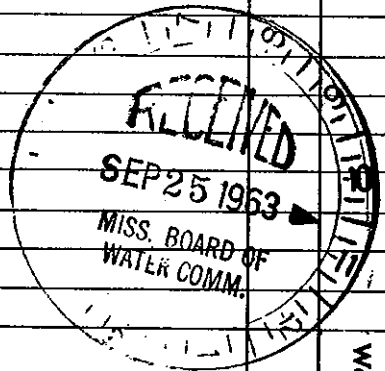

Well No.

(Use Back Side)

Mail this copy to Board of Water Commissioners 429 Miss. St. Jackson, Miss.