

MISSISSIPPI
BOARD OF WATER COMMISSIONERS
416 North State Street
Jackson, Mississippi 39201

CODED

WATER WELL DRILLERS LOG

Covington
G20
10-25-68

10-25-68 date well completed
Beaman Thrasa firm name
Covington county well located

LANDOWNER:
Wilton Rodgers
Collins, Miss
(mailing address)

description of formations encountered	from	to
Chalk	0	10
Sand	10	13
Chalk	13	70
Sand (fine)	70	38
Chalk	38	120
Sand	120	175

WELL LOCATION:
sec. 2 T. 8 S. R. 15 E
10 miles E of Collins
(distance) (direction) (nearest town)

WELL PURPOSE:
(home, irrigation, municipal, industrial)

WELL COMPLETION DATA:

(1) diameter (inches) 2"

(2) total depth (feet) 175'

(3) static water level (feet) 38' below above top of ground.


(4) casing galv. 165' (material) (depth)
If telescope see back.
(size)

(5) screen 10' (length) (depth to top)
2" Brass (size) (material)

(6) pump 1 15 (HP) (yield gpm)
220 (type power)

(7) electric log No (yes or no)
(organization running log)

(8) how well bottom plugged B.P. Value

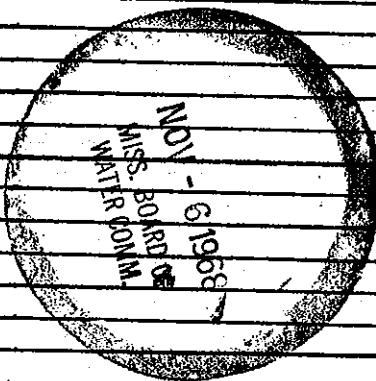

DRILLERS REMARKS: