


OG 25

WATER WELL DRILLERS LOG

CODED

Date: 5-22-62 Driller: Jay Lott County: Couington
 Name: Hattie Lee G. Butane G. ed

(1) Owner of Land:	Description & Color of Materials Sand, Clay, Red Clay, Shell, etc.	Thick- ness Feet	Depth Feet
<u>L. J. Leggett</u> (Name) <u>Collins Miss</u> (Address)	<u>red clay</u>	<u>0</u>	<u>30</u>
	<u>red sand</u>	<u>30</u>	<u>50</u>
(2) Location: <u>1/4</u> , <u>1/4</u> , Sec <u>28</u> T <u>8N</u> R <u>15W</u> _____ miles _____ of _____ (distance) (direction) (Nearest Town)	<u>white sand</u>	<u>50</u>	<u>75</u>
(3) Topography: _____ (Hilly) (Flat) (Level)	CODED <u>Inuff info to locate.</u>		
(4) Purpose of Well: _____ (Domestic Irrigation Municipal, Industrial, Other)			
Information upon completion of well:			
(1) Diameter <u>2</u> inches.			
(2) Total Depth <u>75</u> feet.			
(3) Water Level <u>40</u> feet below top of ground.			
(4) Cased to <u>2</u> , Size <u>2</u>			
(5) Screen: Size <u>2</u> , Length <u>10</u>			
(6) Were any formations sealed against pollution? _____ yes, _____ no.			
If YES, depth of formation _____			
Why _____			
Drillers Remarks: _____			

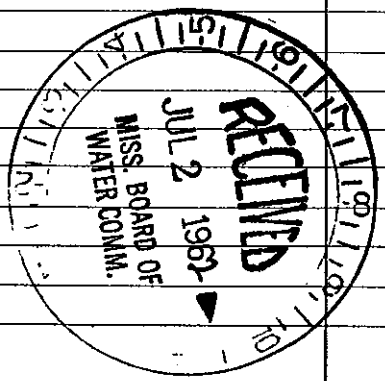

(Use Back Side)

Well No.