

COVINGTON

MISSISSIPPI BOARD OF WATER COMMISSIONERS

G 26

7-27-66

WATER WELL DRILLERS LOG

**CODED**

Date: 7/27, 1966, Driller: Hattiesburg Butane County Covington  
(Name)

(1) Owner of Land: Strebeck  
(Name)  
Collins, Mississippi  
(Address)

(2) Location: 1/4, 1/4, Sec. 32 T8N R15E  
\_\_\_\_\_ miles \_\_\_\_\_ of \_\_\_\_\_  
(distance) (direction) (Nearest Town)

(3) Topography: Level  
(Hilly) (Flat) (Level)

(4) Purpose of Well: domestic  
(Domestic Irrigation  
Municipal, Industrial, Other)

Description & Color of Materials Sand, Clay, Red Clay, Shell, etc.	Thick- ness Feet	Depth Feet
<u>Red clay</u>	<u>0-10</u>	
<u>Blue Sand</u>	<u>10-24</u>	
<u>white clay</u>	<u>24-67</u>	
<u>white sand</u>	<u>67-87</u>	
<u>white clay</u>	<u>87-104</u>	
<u>Blue Sand</u>	<u>104-142</u>	

Information upon completion of well:

(1) Diameter 2 inches.

(2) Total Depth 142 feet.

(3) Water Level 60 feet below top of ground.

(4) Cased to \_\_\_\_\_, Size \_\_\_\_\_.

(5) Screen: Size 3", Length 10'.


(6) Were any formations sealed against pollution?  
\_\_\_\_\_ yes, X no.

**CODED**

If YES depth of formation \_\_\_\_\_

Why \_\_\_\_\_

Drillers Remarks: \_\_\_\_\_

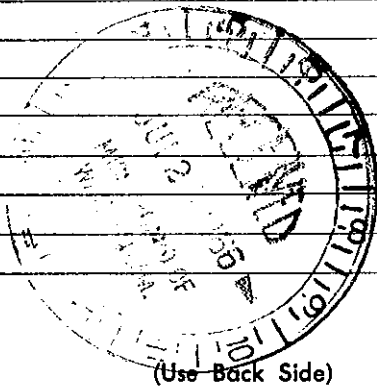

(Use Back Side)

Well No.

Mail this copy to Board of Water Commissioners 429 Miss. St. Jackson, Miss