

**COVINGTON**  
**G. 31**  
**11-2-74**

MISSISSIPPI **CODED**  
 BOARD OF WATER COMMISSIONERS  
 416 North State Street  
 Jackson, Mississippi 39201

**WATER WELL DRILLERS LOG**

*Thelma Craft* 1974 *W.K. Barnes Water Well Construction*  
 date well completed firm name county well located

LANDOWNER: *Thelma Craft*  
*pt. 1*  
*Collins cross*  
 (mailing address)

WELL LOCATION:  
 sec *29* T *8* N R *15* E  
*3* miles *West* of *Collins*  
 (distance) (direction) (nearest town)

WELL PURPOSE: *Home*  
 (home, irrigation, municipal, industrial)

WELL COMPLETION DATA:

(1) diameter (inches) 2

(2) total depth (feet) 663

(3) static water level (feet) 92 below top of ground.

(4) casing Galv. (material) (depth) 2 if telescope see back. (size)


(5) screen 8 (length) (depth to top) 06 S.S. (size) (material)

(6) pump 1 1/2 (HP) 10 (yield gpm)  
Elec. (type power)

(7) electric log no (yes or no)  
 (organization running log)

(8) how well bottom plugged Wash Valve

description of formations encountered	from	to
Red Clay	0	8
yellow clay	8	60
Fine Sand	60	63
yellow clay	63	81
Fine Sand	81	84
Blue Clay	84	110
Rock	110	113
Blue Clay	113	286
Rock	286	293
Blue Clay	293	350
Hard Rock	350	355
Blue Clay	355	410
Real Fine Sand	410	430
Blue Clay	430	490
Fine Sand	490	620
Medium Sand	620	663

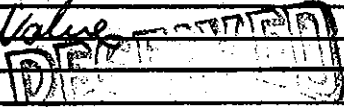

DEC 9 1974

MISS. BD. OF WATER COMM