	STATE WELL REPORT	
county: Covineton	Part 1	For Office Use Only:
Permit #:	Driller's Log	Well #:
Driller: James M. Wells	Mississippi Department of Environmental Quality Office of Land and Water Resources	Aquifer:
Date drilling completed: 4-17-16	P.O. Box 2309	E-Log #:
	Jackson, MS 39225-2309 (601)961-5210	
	(601)360-0535 (fax)	
State Law requires that this report Department at the above address w	be prepared by the license holder responsible for the hold of the self of the	he work and filed with the
well Owner Informati	on or Estimular David	hole Location /17
(Landowner if borehole is not for	a water well) Latitude: 31°39,918 Lon	$= \nabla Q^{0} 3 \wedge \nabla T =$
Owner Name: Justin Ki	rkland	gitude: 17 JU, AS
Mailing Address:	Method of Lat/Long (check one)	: Conventional Survey,
2356 HWV 84	USGS quad, Hand-held GF	
Collins MS	3942 NE NIN I	<u>S</u> T <u>SN</u> RJSL
City State		
Telephone No. (601) 517-176	Miles of	Collins
	(Distance) (Direction)	(Nearest Town)
Aame of organization running log(s):	Geotechnical/Geological Investigation Gr Survey Other (<i>describe</i>) and to water well construction, skip the remainder of the state of the second state of the s	Other:
ther (describe): Chicker	house house	h Culture
a flowing well, method of flow regulati	on: Valve Other (<i>describe</i>)	
atic Water Level: <u>100</u> feet [a	bove or below] land surface Date measured: _	4-17-16
ethod of measurement (circle one): Stee	el tape Electric tape Air line Other (describe)	
ell depth: <u>220</u> Well grouted to a de	pth of: 10 feet Type of grout (circle one):	Pat Comont Postanita III
ising length: <u>70</u> feet Casin	g diameter:inches Type of casi	-
reen length: <u>30</u> feet Scre	en diameter:inches Type of scre	
reen slot size:		
	Setting depth: Fromfeet to	Odo Rotania
pe of completion (circle all applicable):	Gravel packed Underreamed Open hole	Natural Development
her (describe):		JUN 2 9 2016
o of lap pipe or reduction in casing:	feet	
	l or more than one screen, describe on next page	By OLW

1

Form: OLWR-SWR-1A (4/13)


County: Covington	<u> </u>
Permit #:	-

For Office Use Only:

Well #: _____

The sketch below only required for water wells

If well telescopes, show depths on sketch.

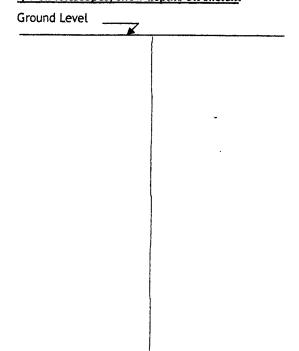

<u>Description of formations encountered must be provided for all wells</u> and boreholes, unless specifically exempted by regulations

Description of Formations Encountered	From (depth)	To (depth)
topsoil	Ground level	1
clay		265
sand	265	320
]

If more than one screen, show location of each on sketch

Sketch the property layout and include the following:
1) the well location
2) any permanent structures on the property that may aid in locating the well
3) any roads nower lines or other items that may aid in locating the well
3) any roads, power lines, or other items that may aid in locating the property and the well 4) north arrow
+) horth arrow
Chicken house
Xwell
Received
a coiveu
DACENT
JUN 2 9 2016
Ato,
Hwy 84 By OLWR
Husy 84 DU OLIVIT
Landowner Name:UStin_Kirkland
HEREBY CERTIFY that the well/horehole was drilled constructed and completed in according to the state of the second
I HEREBY CERTIFY that the well/borehole was drilled, constructed, and completed in accordance with all applicable
requirements of the Mississippi Department of Environmental Quality and the Mississippi Department of Health regulations, if applicable, and state laws.
in applicable, and state laws.
James M. Wells 00005889 (02711 James D. C
chills Fill whe unus of lot 116 same no free 6
Print Name of Responsible Licensee and License No. Date Signature of Licensee

Form: OLWR-SWR-1A (4/13)

	STATE WELL REPORT					
County: Course for	Part 2	For Office Use Only:				
Permit #:	Pump Installer's Completion Report Mississippi Department of Environmental Quality	Well #:				
Driller: James M. Wells	Office of Land and Water Resources	Well #				
Date completed: 4.17-16	P.O. Box 2309 Jackson, MS 39225-2309	Aquifer:				
Copy information from block on Part 1	(601)961-5210 (601) 360-0535 (fax)					
This part of the report must be complete of the report must be attached and both	This part of the report must be completed by a licensed water well contractor or a licensed pump installer. A copy of Part 1 of the report must be attached and both parts filed with the Department at the above address within 30 days of well completion.					
Well Owner Information Well Location						
Owner Name: Justin K	irtland Latitude: 31.39.918 Lor	ngitude: 87 30. 735				
Mailing Address:	Method of Lat/Long (check one): Conventional Survey,				
2356 Hwy 84	2356 Hwy 84 USGS quad, Hand-held GPS, Survey-grade GPS USGS quad, Hand-held GPS, Survey-grade GPS USGS quad, Hand-held GPS, Survey-grade GPS State Zip Code X Hilor F. of Calling S					
Collins MS	39428 4, Sec_	T R				
		f <u>Collins</u> (Nearest Town)				
Telephone No. (601) 517-176	(Distance) (Direction)	(Nearest Town)				
	Pump Type (circle one)	<u></u>				
	ugal Flowing Well Jet Piston Rotary Other (de					
Date Pump installed:	Rated Pump Capacity:	Gallons Per Minute				
Is This Pump (circle one): New Re	paired Replacement					
	Power Type (circle one)					
	Tractor PTO Windmill Other (describe):					
Horse Power Rating of Motor:	Setting Depth:feet Number	of Stages:				
	Pump Test Data for Non Flowing Well					
Date Well Tested: 4-17-16	Duration of Pump Test (minin	num 4 hours): hours				
Static Water Level (A): _/OOFee	t Below Land Surface Pumping Water Level (B):	Feet Below Land Surface				
Drawdown [(B) - (A)]: H2 90	Feet Below Land Surface Test Pumping Rate:	45 Gallons Per Minute				
Method of measurement (circle one): Si	teel tape Electric tape Air line Other (describe):					
	Pump Test Data for Flowing Well					
Measured shut in head:feet	t.					
Well yielded GPM with a d	drawdown of feet after	_hours of pumping				
	Meter Installation					
Meter Manufacturer:	Meter Serial Number:	Dessived				
	Type of Meter:					
Totalizer Register Unit and Multiplier F	actor (AF x .001, gal x 1000, etc):	<u>11 1kt 9 a 2016</u>				
Installation Date:	Totalizer Register Unit and Multiplier Factor (AF x .001, gal x 1000, etc): JUN 292016 Installation Date: Meter installed by:					
Is This Meter (circle one): New Repaired Replacement.						
Important: By submitting the above information you are certifying that this meter was installed to manufacturer standards. For agricultural wells, a list of approved meters is on the MDEQ website.						
I HEREBY CERTIFY that the above statements are true to the best of my knowledge.						
The Multiple ANNESSE 12211 the multiple						
Tames M. Wells 00005889 Print Name of Pump Installer and License No. (if applicable) Date Signature of Pump Installer						

Т. 5 **у**