

Couington
G 2000
4-68

MISSISSIPPI
BOARD OF WATER COMMISSIONERS
416 North State Street
Jackson, Mississippi 39201

WATER WELL DRILLERS LOG

4-29 1968 Nattiesburg Butane (COUINGTON?)
date well completed firm name county well located

LANDOWNER: I. S. SULLIVAN

Route 4
Collins, Miss.
(mailing address)


WELL LOCATION:
sec 18 T 8 N R 15 E
1 miles (distance) of Collins (direction) (nearest town)

WELL PURPOSE: home
(home, irrigation, municipal, industrial)

WELL COMPLETION DATA:

- (1) diameter (inches) 2"
- (2) total depth (feet) 190'
- (3) static water level (feet) 62' below top of ground.
- (4) casing GALV. 190' (material) (depth)
2" (size) if telescope see back.
- (5) screen 10' 190' (length) (depth to top)
2" STAINLESS STEEL (size) (material)
- (6) pump 1 500hp 9 (HP) (yield gpm)
Electric (type power)
- (7) electric log no (yes or no)
no (organization running log)
- (8) how well bottom plugged BACK WASH VALVE

description of formations encountered	from	to
yellow clay	0	5
white clay	6	24
gray clay	25	27
white hard clay	28	52
white sand	53	57
white clay	58	72
black clay	73	90
white sand with blue specks, small gravel	91	190

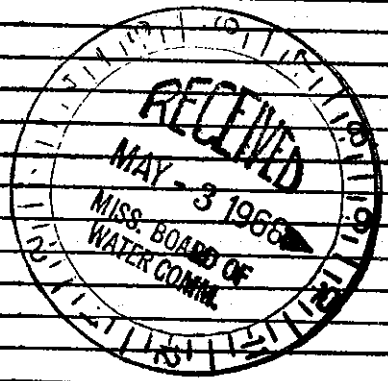

DRILLERS REMARKS: