

COVINGTON
H 10
11-22-74

MISSISSIPPI
 BOARD OF WATER COMMISSIONERS
 416 North State Street
 Jackson, Mississippi 39201

WATER WELL DRILLERS LOG CODED

Nov 22 1974 Roy West Water Wells Covington
 date well completed firm name county well located

LANDOWNER: Roger & Spud
Rt 3 Collins
 (mailing address)

description of formations encountered	from	to
clay	0	8
sand	8	15
clay	15	50
sand	50	70

WELL LOCATION:
 sec. 7 T 8 N R 14 E
8 miles E of Collins
 (distance) (direction) (nearest town)

WELL PURPOSE: Home
 (home, irrigation, municipal, industrial)

WELL COMPLETION DATA:

(1) diameter (inches) 2

(2) total depth (feet) 70

(3) static water level (feet) 22 below above top of ground.

(4) casing PVC 60
 (material) (depth)
 (size) If telescope see back.


(5) screen 10 60
 (length) (depth to top)
2 in PVC
 (size) (material)

(6) pump 1 10
 (HP) (yield gpm)
R&A
 (type power)

(7) electric log No
 (yes or no)

(organization running log)

(8) how well bottom plugged was checked

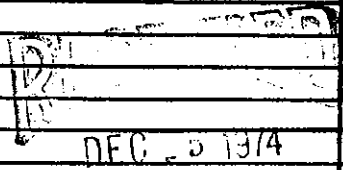

DRILLERS REMARKS:

MISS. BD. OF WATER COMM