
County: <u>Corving Ton</u> Permit #: <u>Driller: John W Thompson</u> Date drilling completed: <u>1-1-16</u> Mississippi Departme Office of Land P.C Jackson (60)	ELL REPORT Part 1 Iler's Log Int of Environmental Quality and Water Resources Box 2309 MS 39225-2309 1)961-5210 60-0535 (fax)	For Office Use Only: Well #: H 3 4* Aquifer:
State Law requires that this report be prepared by the lic Department at the above address within 30 days of comp Well Owner Information (Landowner if borehole is not for a water well)	<i>letion of drilling of the well o</i> Well or Borel	
Owner Name: <u>Mossbacher</u> Mailing Address: <u>712 Main St ste 2200</u> M <u>Houston TX 77002</u> U	ethod of Lat/Long (check one) SGS quad, Hand-held GP SE4NE_14, Sec	: Conventional Survey, PS, Survey-grade GPS 19T <i>SN</i> _R14 <i>W</i> _
City State Zip Code	Miles of Distance) (Direction)	(Nearest Town)
Date drilling started: 1-1-16 Date drilling completed: 1 Location of the source of any surface water used for drilling: Method of dosing and volume of Chlorine used in drilling and Logs run (<i>circle all applicable</i>): To log run Electric Gamma 1 Name of organization running log(s): Purpose of borehole (<i>circle one</i>) Water Welt Geotechnical Seismic Survey Other (<i>des</i>	<u>Creek</u> development: <u>added</u> Ray Density Sonic Neutron Geological Investigation Gi	6 gallons of blench
r's a sale		sh Culture
If a flowing well, method of flow regulation: Valve Static Water Level:66feet [above or (below) la (circle one)		
Screen length: <u>60</u> feet Screen diameter: <u>6</u> Screen slot size: <u>608</u> inches Setting depth: Fr	Type of grout (circle one): N inches Type of cas inches Type of sc	eat Cement Bentonite Mix sing:
Other (describe):		

County: _	Covington
	<i>J</i>
Permit #:	

F	or Office Use Only:
Well #:	H34

The sketch below only required for water wells

If well telescopes, show depths on sketch.

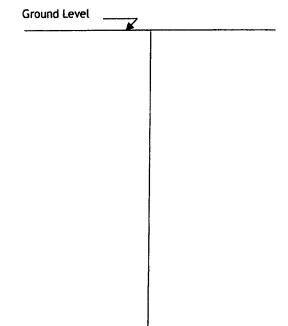

Description of formations encountered must be provided for all wells and boreholes, unless specifically exempted by regulations

Description of Formations Encountered	From (depth)	To (depth)
Description of Formations Encountered	Ground level	120
Sand	120	200
· · · · · · · · · · · · · · · · · · ·		
	LI	

Sketch the property layout and include the following:

If more than one screen, show location of each on sketch

1) the well location

any permanent structures on the property that may aid in locating the well
 any roads, power lines, or other items that may aid in locating the property and the well

4) north arrow

Mossbac Landowner Name:

HEREBY CERTIFY that the well/borehole was drilled, constructed, and completed in accordance with all applicable requirements of the Mississippi Department of Environmental Quality and the Mississippi Department of Health regulations, if applicable, and state laws. 1

John W Thompson 0-679		_Sch	Signature of Lizensee	
Print Name of Responsible/Licensee and License No.	Date			
			Form: OLWR-SWR-1A	(4/13)

STATE WELL REPO	RT
County: Corington Part 2	For Office Use Only:
Permit #: Pump Installer's Completio	n Report
Driller: John W Thompson Mississippi Department of Environme Office of Land and Water Reso	
Date completed: /-/-/b P.O. Box 2309	
Copy information from block on Part 1 (601)961-5210	Aquiter,
(601) 360-0535 (fax)	
This part of the report must be completed by a licensed water well contractor of of the report must be attached and both parts filed with the Department at the a	a licensed pump installer. A copy of Part 1 bove address within 30 days of well completion.
Well Owner Information	Well Location
Owner Name: Mossbacher Latitude: 31°	38 '490 Longitude: <u>89° 26' 15.8'</u>
and the states of the states o	ong (check one): Conventional Survey,
	, Hand-held GPS, Survey-grade GPS
	<u></u>
City State Zip Code 7	E of Collins
Telephone No. () Miles	(Direction) (Nearest Town)
Pump Type (circle one)	
Submersible Turbine Air Lift Centrifugal Flowing Well Jet Piston Rot	
Date Pump Installed: Rated Pump Capac	ity:Gallons Per Minute
s This Pump (circle one): (New) Repaired Replacement	· · · · · · · · · · · · · · · · · · ·
Power Type (circle one)	:
Electric Diesel Gasoline Natural Gas Tractor PTO Windmill Other (deso	
Horse Power Rating of Motor:5 Setting Depth:1070	feet Number of Stages:
Pump Test Data for Non Flowing	
	p Test (minimum 4 hours): hours
Static Water Level (A): <u>66</u> Feet Below Land Surface Pumping Wate	r Level (B): Feet Below Land Surface
Drawdown [(B) - (A)]:34 Feet Below Land Surface Test Pump	ing Rate: Gallons Per Minute
Method of measurement (circle one): Steel tape Electric tape Air line Oth Pump Test Data for Flowing We	
Pump Test Data for Flowing We	
Pump Test Data for Flowing We Measured shut in head:feet.	211
Pump Test Data for Flowing We Measured shut in head:feet. Vell yieldedGPM with a drawdown offeet after Meter Installation	211
Pump Test Data for Flowing We Measured shut in head:feet. Vell yieldedGPM with a drawdown offeet after Meter Installation	211
Pump Test Data for Flowing We Measured shut in head:feet. Vell yieldedGPM with a drawdown of feet_after Meter Installation Meter Manufacturer: Meter Seria	ellhours of pumping
Pump Test Data for Flowing We Measured shut in head:feet. Vell yieldedGPM with a drawdown offeet after Meter Installation Meter Manufacturer: Meter Model Number/Name:	ellhours of pumping I Number:
Pump Test Data for Flowing We Measured shut in head: feet. Vell yielded feet after Meter Installation feeter Manufacturer: Meter Manufacturer: Meter Seria Meter Model Number/Name: Type of Me Iotalizer Register Unit and Multiplier Factor (AF x .001, gal x 1000, etc):	ellhours of pumping { Number: eter:
Pump Test Data for Flowing We Measured shut in head:feet. Vell yieldedGPM with a drawdown offeet after Meter Installation Meter Installation Meter Manufacturer: Meter Model Number/Name: Type of Me Totalizer Register Unit and Multiplier Factor (AF x .001, gal x 1000, etc): Meter installed by:	ellhours of pumping { Number: eter:
Pump Test Data for Flowing We Measured shut in head: feet. Well yielded feet after Meter Installation feet after Meter Manufacturer: Meter Model Number/Name: Totalizer Register Unit and Multiplier Factor (AF x .001, gal x 1000, etc):	ellhours of pumpinghours of pu
Weasured shut in head: feet. Well yielded feet after Meter Installation Meter Installation Weter Manufacturer: Meter Seria Weter Model Number/Name: Type of Meter Seria Fotalizer Register Unit and Multiplier Factor (AF x .001, gal x 1000, etc):	ellhours of pumping
Pump Test Data for Flowing We Weasured shut in head: feet. Well yielded GPM with a drawdown offeet after Meter Installation Meter Installation Meter Manufacturer: Meter Seria Meter Model Number/Name: Type of Me Fotalizer Register Unit and Multiplier Factor (AF x .001, gal x 1000, etc):	ellhours of pumping

٠

•