

COUINGTON MISSISSIPPI BOARD OF WATER COMMISSIONERS

J  
6-24-61

WATER WELL DRILLERS LOG

Jeff Davis

Date: 6-24, 1961, Driller: HERMON PARKER County COUINGTON  
(Name)

	Description & Color of Materials Sand, Clay, Red Clay, Shell, etc.	Thick- ness Feet	Depth Feet
(1) Owner of Land: <u>VIRGIL MAGEE</u> (Name) <u>Rt. 1 Collins, Miss</u> (Address)	<u>Red Chalk</u>	<u>20</u>	<u>20</u>
(2) Location: _____ 1/4, _____ 1/4, Sec. <u>16</u> T. <u>R.</u>	<u>SAND</u>	<u>48</u>	<u>68</u>
<u>12</u> miles <u>South West</u> <u>Collins</u> (distance) (direction) (Nearest Town)			
(3) Topography: <u>Hilly</u> (Hilly) (Flat) (Level)			
(4) Purpose of Well: <u>Domestic</u> (Domestic Irrigation Municipal, Industrial, Other)			


Information upon completion of well:

- (1) Diameter 9 inches.
- (2) Total Depth 68 feet.
- (3) Water Level 32 feet below top of ground.
- (4) Cased to 68', Size 2"
- (5) Screen: Size 2", Length 5'
- (6) Were any formations sealed against pollution?  
\_\_\_\_\_ yes, no no.

If YES depth of formation \_\_\_\_\_

Why \_\_\_\_\_

Drillers Remarks: \_\_\_\_\_

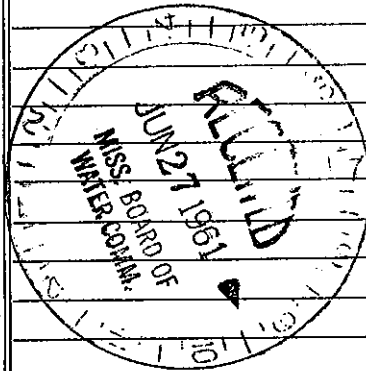

28

Well No.

(Use Back Side)

Mail this copy to Board of Water Commissioners 429 Miss. St. Jackson, Miss