

J4
7-7-60

WATER WELL DRILLERS LOG

Date: July 7, 1960, Driller: DAVE NEWELL ² ~~SON~~ _{County} PERRY
(Name)

	Description & Color of Materials Sand, Clay, Red Clay, Shell, etc.	Thick- ness Feet	Depth Feet
(1) Owner of Land: <u>JOHN DICKING</u> (Name) <u>RED #3, SUMERALL, MISS</u> (Address)	<u>RED CLAY</u>	<u>0-40</u>	
(2) Location: <u>N 1/4, S 1/4, Sec 23 T4 R16 W</u>	<u>SAID</u>	<u>40-70</u>	
<u>11</u> miles <u>NORTH</u> of <u>SUMERALL</u> (distance) (direction) (Nearest Town)			
(3) Topography: <u>HILLY</u> (Hilly) (Flat) (Level)			
(4) Purpose of Well: <u>DOMESTIC</u> (Domestic Irrigation Municipal, Industrial, Other)			


Information upon completion of well:

- (1) Diameter 2 inches.
- (2) Total Depth 70 feet.
- (3) Water Level 55' feet below top of ground.
- (4) Cased to 2 1/2 ft, Size 2 in.
- (5) Screen: Size 2 in, Length 6 ft.
- (6) Were any formations sealed against pollution?
 yes, no.

If YES depth of formation 40 ft

Why THE BOTTOM OF THE CLAY

Drillers Remarks:

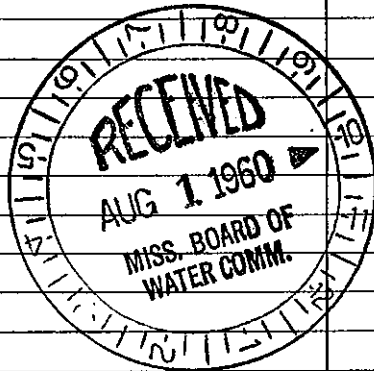

70
Well No.

(Use Back Side)