

COUINGTON

J5

7-20-62

Date: 7-20, 1962, Driller: Hermon Park County Couington

WATER WELL DRILLERS LOG

(Name)

(1) Owner of Land:	Description & Color of Materials Sand, Clay, Red Clay, Shell, etc.	Thick- ness Feet	Dept Feet
<i>M^{rs} Kinley Barnes</i> (Name)	<i>red clay</i>	<i>40</i>	<i>40</i>
<i>Rt. 3 Collins</i> (Address)	<i>sand</i>	<i>28</i>	<i>68</i>
(2) Location: $\frac{1}{4}$, $\frac{1}{4}$, Sec. <i>3</i> T. <i>R.</i>			
<i>7</i> miles <i>5-west</i> of <i>Collins</i> (distance) (direction) (Nearest Town)			
(3) Topography: <i>flat</i> (Hilly) (Flat) (Level)			
(4) Purpose of Well: <i>domestic</i> (Domestic Irrigation Municipal, Industrial, Other)			


Information upon completion of well:

- (1) Diameter *2* inches.
- (2) Total Depth *68* feet.
- (3) Water Level *39* feet below top of ground.
- (4) Cased to *68'*, Size *2"*
- (5) Screen: Size *2"*, Length *5'*
- (6) Were any formations sealed against pollution?
_____ yes, 1 no.

If YES depth of formation _____

Why _____

Drillers Remarks: _____

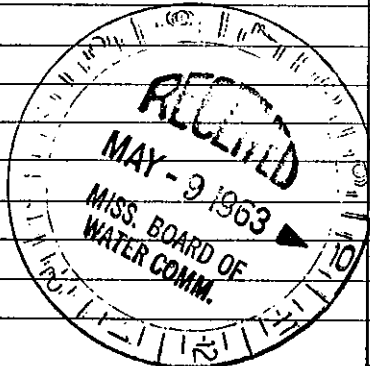

68

48

Well No.

(Use Back Side)

Mail this copy to Board of Water Commissioners 429 Miss. St. Jackson, Miss