

3

State Well Report

Part 1

Mississippi Department of Environmental Quality
Office of Land and Water Resources
P.O. Box 10631
Jackson, MS 39289-0631
(601)961-5210
(601)354-6938 (fax)

For Office Use Only:

Aquifer: _____
Well #: J-28
L. S. Elevation: _____
E-log #: _____

County: Covington 031
Permit #: _____
Driller: James Wells Inc.
Date drilling completed: 9-3-04

James Wells Water Well Service

State Law requires that this report be prepared by the driller in detail and filed with the Department within 30 days of completion of drilling of the well.

Well Owner Information	Well Location
Owner Name: <u>Doug Rogan</u>	Latitude: _____ Longitude: _____
Mailing Address: <u>P.O. Box 1805</u>	Method of Lat/Long (circle one): <input type="checkbox"/> Conventional Survey, <input type="checkbox"/> USGS quad, <input type="checkbox"/> Hand-held GPS, <input type="checkbox"/> Survey-grade GPS
<u>Collins</u> <u>MS</u> <u>39428</u> City State Zip Code	<u>N 1/4 4E 1/4 Sec 6 T16W R7N</u>
Telephone No. <u>(601) 765-2983</u>	Distance <u>6</u> Miles <u>West</u> Direction of <u>Collins</u> Nearest Town

Well Data

Purpose of Well (circle one): Home Industrial Public Supply Irrigation Fish Culture Other: _____

Date well drilling started: 9-3-04 Date well drilling completed: 9-3-04

If flowing, method of flow regulation: Valve _____ Other (describe) _____

Static Water Level: 105 feet above or below (circle one) land surface Date measured: _____

Method of Measurement (circle one): steel tape electric tape air line other: _____

Hole depth: _____ Well depth: _____ Well grouted to a depth of 10 feet

Type of grout (circle one): Cement Bentonite Mix

Casing length: 220 feet Casing diameter: 4 inches Type of casing: PVC

Screen length: 20 feet Screen diameter: 4 inches Type of screen: PVC

Screen slot size: 008 inches Setting depth: From 220 feet to 240 feet

Type of completion (circle all applicable): Gravel packed Underreamed Telescoped Open hole Natural Development

Other (describe): _____

Top of lap pipe or reduction in casing: _____ feet. If telescoped or more than one screen, describe on back of page

Logs run (circle all applicable): No log run Electric Gamma Ray Density Sonic Neutron Other: _____

Name of organization running log(s): _____

RECEIVED
OCT 07 2004
BY: OLWR

I certify that the well was drilled, constructed, and completed in accordance with all applicable requirements of the Mississippi Department of Environmental Quality and/or the Mississippi Department of Health regulations and state laws.


JAMES WELLS 0586 James Wells
Print Name of Water Well Contractor and License No. Signature of Water Well Contractor

J-28

If well telescopes please sketch below and show depths.

Ground Level


J-

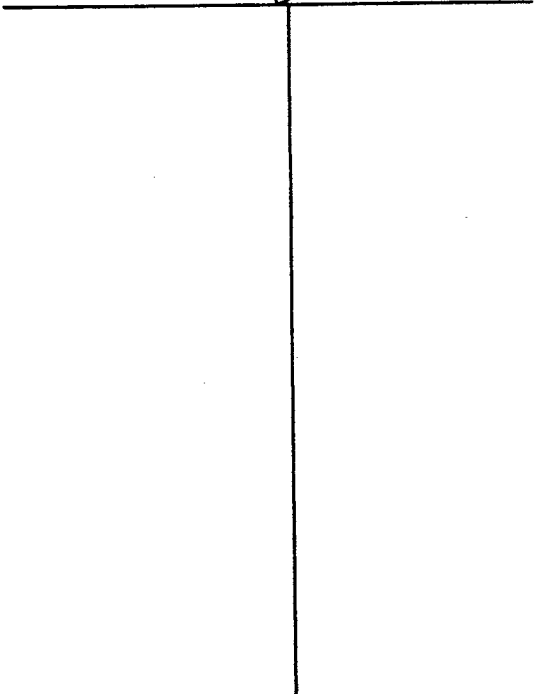

Description of Formations Encountered	From	To
Clay	0	20
Sand	20	70
Clay	20	70
Clay	70	160
Sand	160	240

If more than one screen, show location of each on sketch

Sketch the property layout and include the following: 1) the well location; 2) any permanent structures on the property that may aid in locating the well; 3) any roads, power lines, or other items that may aid in locating the property and the well; 4) indicate direction.

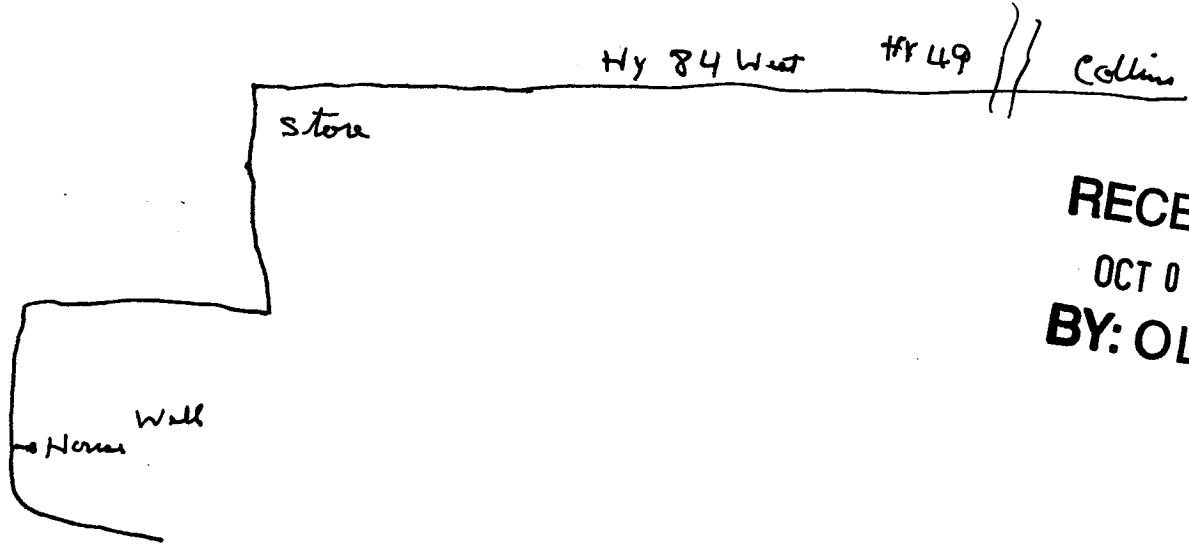

RECEIVED
OCT 07 2004
BY: OLWR

Landowner Name: Doug Rogers

James Wells
Signature of Water Well Contractor

STATE WELL REPORT

Part 2

Pump Installer's Completion Report
Mississippi Department of Environmental Quality
Office of Land and Water Resources
P.O. Box 10631
Jackson, MS 39289-0631
(601)961-5210
(601)354-6938 (fax)

For Office Use Only:

Aquifer: _____

Well #: J-28

Elevation: _____

County: Collington

Permit #: _____

Driller: James Wells Inc.

Date completed: 9-3-04

This report should be prepared by the pump installer in detail and filed with the Department within 30 days of the installation of pump.

Well Owner Information	Well Location
Owner Name: <u>Doug Rogers</u>	Latitude: _____ Longitude: _____
Mailing Address: <u>P.O. Box 1805</u>	Method of Lat/Long (circle one): Conventional Survey, USGS quad, Hand-held GPS, Survey-grade GPS
<u>Colling</u> <u>Ms.</u> <u>39428</u>	<u>W 1/4 NE 1/4</u> Sec <u>6</u> Twn <u>16W</u> Rng <u>7N</u>
City State Zip Code	Distance Direction Nearest Town
Telephone No. <u>(601) 765 2983</u>	<u>6</u> Miles <u>West</u> of <u>Colling</u>

Pump Type Circle one	Power Type Circle one
Air Lift Jet <u>Submersible</u>	Diesel Engine Gasoline Engine Natural Gas
Bucket Piston Turbine	<u>Electric Motor</u> Hand Tractor PTO
Centrifugal Rotary Flowing Well	Windmill Other (specify): _____
Other (specify): _____	Horse Power Rating of Motor: _____
Date Pump Installed: _____	Setting Depth: <u>130</u> feet
Rated Pump Capacity: <u>15</u> Gallons Per Minute	Number of Stages: <u>11</u>

RECEIVED
OCT 07 2004
BY: OLWR

Pump Test Data	Method of Measuring Water Level Circle one
Date Well Tested: _____	Air Line Electric Measuring Line <u>Steel Tape</u>
Static Water Level (A): <u>105</u> Feet Below Land Surface	Other (specify): _____
Pumping Water Level (B): <u>130</u> Feet Below Land Surface	For flowing well, measured shut in head: _____ feet
Drawdown [(B) - (A)]: <u>105</u> Feet Below Land Surface	Well yielded <u>15</u> GPM with a drawdown of
Test Pumping Rate: <u>15</u> Gallons Per Minute	<u>105</u> feet after <u>5</u> hours of pumping
Duration of Pump Test (minimum 4 hours): <u>5</u> hours	

I HEREBY CERTIFY that the above statements are true to the best of my knowledge.

JAMES WELLS 0526
Print Name of Pump Installer and License No. (if applicable)

James Wells
Signature of Pump Installer