

State Well Report

Part 1

Mississippi Department of Environmental Quality
Office of Land and Water Resources
P.O. Box 10631
Jackson, MS 39289-0631
(601)961-5210
(601)354-6938 (fax)

For Office Use Only:

Aquifer: _____
Well #: J-47
L. S. Elevation: _____
E-log #: _____

County: SOVINGTON
Permit #: _____
Driller: J.P. THOMPSON
Date drilling completed: 8/2/06

State Law requires that this report be prepared by the driller in detail and filed with the Department within 30 days of completion of drilling of the well.

Well Owner Information	Well Location
Owner Name: <u>E.O.G. RESOURCES</u>	Latitude: _____ Longitude: _____
Mailing Address: <u>6101 SOUTH BROADWAY</u>	Method of Lat/Long (circle one): Conventional Survey,
<u>SUITE 200</u>	USGS quad, Hand-held GPS, Survey-grade GPS
<u>TYLER TX 75701</u>	_____ 1/4 _____ 1/4 Sec <u>16</u> Twn <u>7N</u> Rng <u>16W</u>
City State Zip Code	Distance Direction Nearest Town
Telephone No. <u>(903) 509 7155</u>	<u>5</u> Miles <u>W</u> of <u>SEMINARY</u>

Well Data

Purpose of Well (circle one) Home Industrial Public Supply Irrigation Fish Culture Other: RIG SUPPLY

Date well drilling started: 8/1/06 Date well drilling completed: 8/2/06

If flowing, method of flow regulation: Valve _____ Other (describe) _____

Static Water Level: 13 feet above or below (circle one) land surface Date measured: 8/2/06

Method of Measurement (circle one) steel tape electric tape air line other: _____

Hole depth: 163 Well depth: 150 Well grouted to a depth of 20 feet

Type of grout (circle one): Cement Bentonite Mix

Casing length: 130 feet Casing diameter: 4 inches Type of casing: P.V.C.

Screen length: 20 feet Screen diameter: 4 inches Type of screen: P.V.C.

Screen slot size: .020 inches Setting depth: From 130 feet to 150 feet

Type of completion (circle all applicable): Gravel packed Underreamed Telescoped Open hole Natural Development

Other (describe): _____

Top of lap pipe or reduction in casing: _____ feet. If telescoped or more than one screen, describe on back of page

Logs run (circle all applicable): No log run Electric Gamma Ray Density Sonic Neutron Other: _____

Name of organization running log(s): _____

I certify that the well was drilled, constructed, and completed in accordance with all applicable requirements of the Mississippi Department of Environmental Quality and/or the Mississippi Department of Health regulations and state laws.

J.P. THOMPSON 0-624
Print Name of Water Well Contractor and License No.

J.P. Thompson
Signature of Water Well Contractor

RECEIVED
AUG 15 2006
BY: OLWR

J-


If well telescopes please sketch below and show depths.

Ground Level

Description of Formations Encountered	From	To
CLAY	0	10
SAND	10	12
CLAY	12	15
SAND	16	35
SANDY CLAY	35	45
SAND	45	163

If more than one screen, show location of each on sketch

Sketch the property layout and include the following: 1) the well location; 2) any permanent structures on the property that may aid in locating the well; 3) any roads, power lines, or other items that may aid in locating the property and the well; 4) indicate direction.

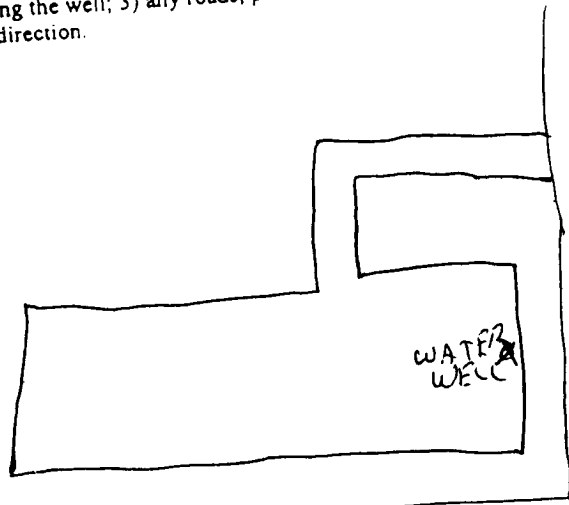

LEASE RD.

Landowner Name: E.O.G. RESOURCES

J.P. Thompson
Signature of Water Well Contractor

STATE WELL REPORT

Part 2

Pump Installer's Completion Report
 Mississippi Department of Environmental Quality
 Office of Land and Water Resources
 P.O. Box 10631
 Jackson, MS 39289-0631
 (601)961-5210
 (601)354-6938 (fax)

County: COVINGTON
 Permit #: _____
 Driller: J.P. THOMPSON
 Date completed: 8/2/06

For Office Use Only:

Aquifer: _____
 Well #: J-47
 Elevation: _____

This report should be prepared by the pump installer in detail and filed with the Department within 30 days of the installation of pump.

Well Owner Information	Well Location
Owner Name: <u>EO-G. RESOURCES</u>	Latitude: _____ Longitude: _____
Mailing Address: <u>6101 SOUTH BROADWAY</u>	Method of Lat/Long (circle one): Conventional Survey,
<u>SUITE 200</u>	USGS quad, Hand-held GPS, Survey-grade GPS
<u>TYLER TX 75701</u>	_____ 1/4 _____ 1/4 Sec <u>16</u> Twn <u>7N</u> Rng <u>16W</u>
City _____ State _____ Zip Code _____	Distance _____ Direction _____ Nearest Town _____
Telephone No. <u>903 509 7155</u>	<u>7</u> Miles <u>W</u> of <u>SEMINARY</u>
<u>(409) 382-3161</u>	

Pump Type Circle one	Power Type Circle one
<input type="checkbox"/> Air Lift <input type="checkbox"/> Jet <input checked="" type="checkbox"/> <u>Submersible</u> <input type="checkbox"/> Bucket <input type="checkbox"/> Piston <input type="checkbox"/> Turbine <input type="checkbox"/> Centrifugal <input type="checkbox"/> Rotary <input type="checkbox"/> Flowing Well Other (specify): _____ Date Pump Installed: _____ Rated Pump Capacity: <u>85</u> Gallons Per Minute	<input type="checkbox"/> Diesel Engine <input type="checkbox"/> Gasoline Engine <input type="checkbox"/> Natural Gas <input checked="" type="checkbox"/> <u>Electric Motor</u> <input type="checkbox"/> Hand <input type="checkbox"/> Tractor PTO <input type="checkbox"/> Windmill Other (specify): _____ Horse Power Rating of Motor: <u>5</u> Setting Depth: <u>80</u> feet Number of Stages: _____

Pump Test Data	Method of Measuring Water Level Circle one
Date Well Tested: <u>8/2/06</u>	<input checked="" type="checkbox"/> <u>Air Line</u> <input type="checkbox"/> Electric Measuring Line <input type="checkbox"/> Steel Tape
Static Water Level (A): <u>13</u> Feet Below Land Surface	Other (specify): <u>WELL SOUNDER</u>
Pumping Water Level (B): <u>36</u> Feet Below Land Surface	For flowing well, measured shut in head: _____ feet
Drawdown [(B) - (A)]: <u>23</u> Feet Below Land Surface	Well yielded <u>100</u> GPM with a drawdown of
Test Pumping Rate: <u>100</u> Gallons Per Minute	<u>23</u> feet after <u>4</u> hours of pumping
Duration of Pump Test (minimum 4 hours): <u>4</u> hours	

I HEREBY CERTIFY that the above statements are true to the best of my knowledge.

J.P. THOMPSON 0-624 J.P. Thompson
 Print Name of Pump Installer and License No. (if applicable) Signature of Pump Installer

RECEIVED
 AUG 15 2006
 BY: OLWR