	STATE '	WELL REPORT				
county: Covington	Part 1		For Office Use Only:			
Permit #:	Driller's Log		Well #: 144			
Driller: James M. Wells	Mississippi Department of Environmental Quality Office of Land and Water Resources		Aquifer:			
Date drilling completed: 8:27-15	F	P.O. Box 2309	E-Log #:			
Date drilling completed:	3	on, MS 39225-2309 601)961-5210				
	(601)360-0535 (fax)					
State Law requires that this report Department at the above address w		mpletion of drilling of the well o	or borehole.			
Well Owner Information (Landowner if borehole is not for a water well)		31 36 32 Well or Borehole Location 89 25 54 Latitude: 31-36.543 Longitude: 089-25.908				
Owner Name: 500H Hick	<u>-</u> S					
Mailing Address:		Method of Lat/Long (check one): Conventional Survey,				
623 Rogers Rd.		USGS quad, Hand-held GPS, Survey-grade GPS				
See: NS 29179		NW 1/4 NW 1/4, Sec 5 T 7N R 14W				
Seminary MS 39479 NW 1/4, Sec. D. T. IN R. 19 City State Zip Code /2 Miles NE of Seminary						
Telephone No. ( <u>(401</u> ) <u>606 - 8</u>	849	(Distance) (Direction)	(Nearest Town)			
Well / Borehole Data						
Date drilling started: $837-15$ Date drilling completed: $837-15$ Hole depth: $170$ Hole diameter: $73''$						
Location of the source of any surface v		Y	<b>▲</b>			
Method of dosing and volume of Chloric	~					
Logs run (circle all applicable): No log run Electric Gamma Ray Density Sonic Neutron Other:						
Name of organization running log(s):						
Purpose of borehole (circle one): Water	Purpose of borehole (circle one): Water Well Geotechnical/Geological Investigation Ground Source Heat Pump					
Seismic Survey Other (describe)						
If drilling is not related to water well construction, skip the remainder of this block						
Purpose of Well (circle all applicable): Home Industrial Public Supply Irrigation Fish Culture						
Other (describe):						
If a flowing well, method of flow regulation: Valve Other (describe)						
Static Water Level: 130 feet [above or below] land surface Date measured: 8-27-15						
Method of measurement (circle one): Steel take Electric tape Air line Other (describe):						
Well depth: 170 Well grouted to a depth of: 10 feet Type of grout (circle one). Neat Cement Bentonite Mix						
Casing length: 150 feet Casing diameter: 4 inches Type of casing: pvc						
Screen length: 00 feet Screen diameter: 1 inches Type of screen: 0/C						
Screen slot size: 1008 inches Setting depth: From 150 feet to 176 feet						
Type of completion (circle all applicable): Gravel packed Underreamed Open hole Natural Development						

\_feet

If telescoped or more than one screen, describe on next page

Other (describe):\_\_\_

Top of lap pipe or reduction in casing: \_\_

Form: OLWR-SWR-1A (4/13)

Natural Development

County:		Fo	or Office Use	e Only:
The sketch below only required for water wells	Description of formations encountered must be provided for all well and boreholes, unless specifically exempted by regulations			
f well telescopes, show depths on sketch.	Description of Formations	Encountered	From (depth)	To (depth)
Ground Level		topso:1	Ground level	
		clay	<del>                                     </del>	1145
		sand	145	170
		<del></del>		
·				
			-	
				+
more than one screen, show location of each on sketch	<u> </u>			
2) any permanent structures on the property that may 3) any roads, power lines, or other items that may aid 4) north arrow	aid in locating the well n locating the property and the	ne wek		
Hwy 590				
(			OCT 0	2015
andowner Name: Scott Hicks				
HEREBY CERTIFY that the well/borehole was drilled equirements of the Mississippi Department of Environ applicable, and state laws.	, constructed, and comple nmental Quality and the M	ted in accordar ississippi Depar	nce with all app tment of Healt	olicable th regulations
James M. Wells 00005889	4.28.15	anne:	~ 1 . /	<i>*</i> .
ו ט ט כטטטט פוגאנו ויין פוואיא	10017	·~~~~	اسعمر) ۱۲۰	م

## STATE WELL REPORT

County: Covinston

Date completed: 8.27-15

Permit #:

## Part 2

Pump Installer's Completion Report
Mississippi Department of Environmental Quality
Office of Land and Water Resources P.O. Box 2309

Jackson, MS 39225-2309

For Office Use Only:	Section of the latest and the latest
Aquifer:	


Copy information from block on Part 1	(601) 360-0535 (fax)				
	water wall contractor or a licensed nump installer. A copy of Part 1				
of the report must be attached and both parts filed with t					
Well Owner Information	31 34 32 Well Location 89 25 54 Latitude: 31° 36,543 Longitude: 089° 25.908				
Owner Name: 5004 Hicks					
Mailing Address:	Method of Lat/Long (check one): Conventional Survey,				
623 Rogers Rd.	USGS quad, Hand-held GPS, Survey-grade GPS				
Sparing (1) 279 [	2 NW 1/4 NW 1/4, Sec_ 5 T_ 7N R 14W				
uicy r	d Miles VI of Jenningry				
Telephone No. ( <u>601)</u> <u>1006 - 8849</u>	(Distance) (Direction) (Nearest Jown)				
•	o Type (circle one)				
Submersible Turbine Air Lift Centrifugal Flowing W	Vell Jet Piston Rotary Other (describe):				
Date Pump Installed: 8-27-15 Rated Pump Capacity: 12 Gallons Per Minute					
Is This Pump (circle one): (New) Repaired Replace					
Powe	er Type (circle one)				
Electric Diesel Gasoline Natural Gas Tractor PTO	Windmill Other (describe):				
Horse Power Rating of Motor: Setting	Depth: 160 feet Number of Stages: 14				
Pump Test Data for Non Flowing Well					
Date Well Tested: 8.27-15 Duration of Pump Test (minimum 4 hours): hours					
Static Water Level (A): 130 Feet Below Land Surface Pumping Water Level (B): Feet Below Land Surface					
Drawdown [(B) - (A)]: 139 30 Feet Below Land Surface Test Pumping Rate: 17 Gallons Per Minute					
Method of measurement (circle one) Steel tape Electric tape Air line Other (describe):					
Measured shut in head:feet.					
	feet afterhours of pumping				
Meter Installation					
Meter Manufacturer:					
	Type of Meter:				
	)1, gal x 1000, etc):				
,	d by:				
Is This Meter (circle one): New Repaired Replacement					
Important: By submitting the above information you are certifying that this meter was installed to manufacturer standards.  For agricultural wells, a list of approved meters is on the MDEQ website.					
I HEREBY CERTIFY that the above statements are true	e to the best of my knowledge.				
	0 28.5 to a m. 201.07.4.2015				
	1				

Print Name of Pump Installer and License No. (If applicable)

4.0017 Date

Signature of Pump Installer

Form: OLWR-SWR-1B (4/13)

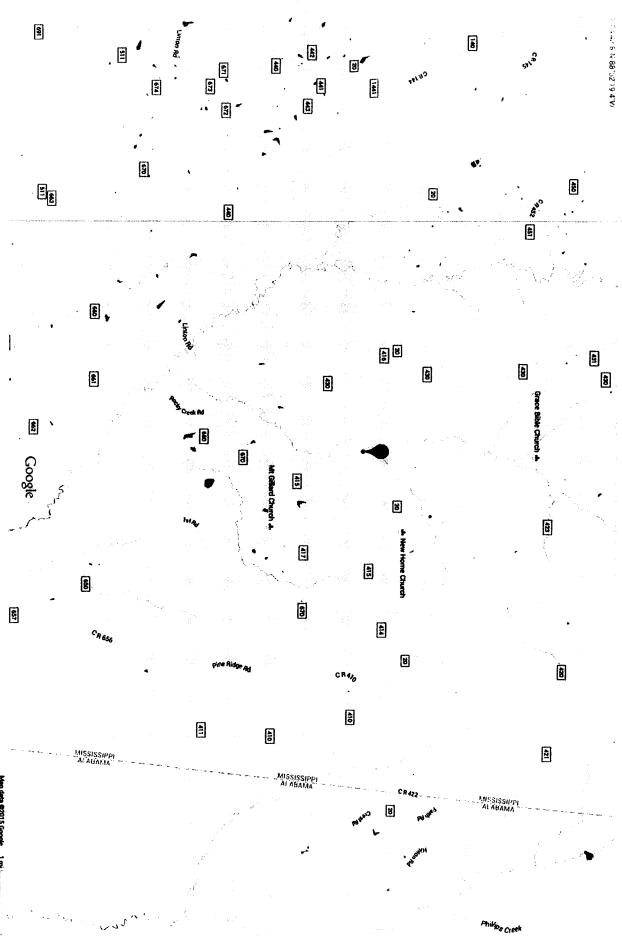

C)