

COVINGTON MISSISSIPPI BOARD OF WATER COMMISSIONERS

KI 800 2608
4-28-64

WATER WELL DRILLERS LOG

CODED

Date: April 28, 19 64, Driller: Carloss Well Supply County Covington
(Name)

(1) Owner of Land: Town of Seminary
(Name)
Seminary, Mississippi
(Address)

(2) Location: 1/4, 1/4, Sec. 22 T. 7 R. 15
_____ miles _____ of _____
(distance) (direction) (Nearest Town)

(3) Topography: (Hilly) (Flat) (Level)

(4) Purpose of Well: Municipal
(Domestic Irrigation, Municipal, Industrial, Other)

Description & Color of Materials Sand, Clay, Red Clay, Shell, etc.	Thick- ness Feet	Depth Feet
Top Soil	3'	3'
Red Clay	5'	8'
White Chalky Shale, Hard	87'	95'
Hard Blue Shale with Streaks White Chalk	27'	122'
Fine Brown Sand	5'	127'
Hard Blue Shale	22'	149'
Med. White W.B. Sand Bottom 20' very coarse with small Pea Gravel	102'	251'
Soft Blue Shale	17'	268'

Information upon completion of well:


- (1) Diameter 16 inches.
- (2) Total Depth 249 feet.
- (3) Water Level 82 feet below top of ground.
- (4) Cased to 180, Size 16"
- (5) Screen: Size 8" I.D., Length 67'
- (6) Were any formations sealed against pollution?
X yes, _____ no.

If YES depth of formation Cemented Casing

Why _____

Drillers Remarks: _____

CODED

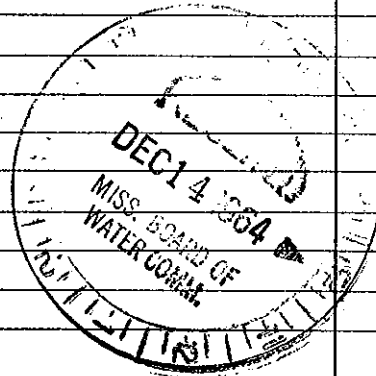

(Use Back Side)

Well No.

Retain this copy for your office files.