

COVINGTON MISSISSIPPI BOARD OF WATER COMMISSIONERS

K9


12-9-60

WATER WELL DRILLERS LOG

11300

Date: 12-9-1960 Driller: HERMON PARKER County Covington

	Description & Color of Materials Sand, Clay, Red Clay, Shell, etc.	Thick- ness Feet	Depth Feet
(1) Owner of Land: <u>ROB ADAMS</u> <small>(Name)</small>			
<u>SEMIWAY</u> <small>(Address)</small> 11155	Blue CHALK SAND	125 25	125 25
(2) Location: <u>1/4</u> , <u>1/4</u> , Sec. <u>2 E R</u>			
<u>1/4</u> miles <u>EAST</u> , of <u>SEMIWAY</u> <small>(distance) (direction) (Nearest town)</small>			150/150
(3) Topography: <u>FLAT</u> <small>(Hilly) (Flat) (Level)</small>			
(4) Purpose of Well: <u>DOMESTIC</u> <small>(Domestic Irrigation) (Municipal, Industrial, Other)</small>			
Information upon completion of well:			
(1) Diameter <u>2</u> inches.			
(2) Total Depth <u>150</u> feet.			
(3) Water Level _____ feet below top of ground.			
(4) Cased to <u>150'</u> , Size <u>2"</u>			
(5) Screen: Size <u>2"</u> , Length <u>5'</u>			
(6) Were any formations sealed against pollution? <u>no.</u>			
If YES depth of formation _____			
Why _____			
Drillers Remarks: _____			

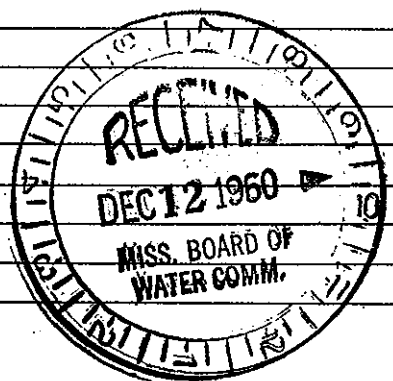

(Use Back Side)

Well No. 11

Mail this copy to Board of Water Commissioners 429 Miss. St. Jackson, Miss.