

COVINGTON MISSISSIPPI BOARD OF WATER COMMISSIONERS

K 10


6-23-61

WATER WELL DRILLERS LOG

K 301

Date: 6-23, 1961, Driller: HERMON PARKER County: COVINGTON  
(Name)

	Description & Color of Materials Sand, Clay, Red Clay, Shell, etc.	Thick- ness Feet	Depth Feet
(1) Owner of Land: <u>F.V. Pace</u> (Name) <u>Rt. 3 SEMINARY MISS</u> (Address)	<u>RED CLAY</u>	<u>80</u>	<u>80</u>
(2) Location: <u>1/4</u> , <u>1/4</u> , Sec. <u>3</u> T. <u>R.</u> <u>2 1/2</u> miles <u>North</u> , of <u>Seminole</u> (distance) (direction) (Nearest Town)	<u>SAND</u>	<u>40</u>	<u>120</u>
(3) Topography: <u>Hilly</u> (Hilly) (Flat) (Level)	<u>Blue CHALK</u>	<u>150</u>	<u>270</u>
(4) Purpose of Well: <u>Domestic</u> (Domestic Irrigation Municipal, Industrial, Other)	<u>SAND</u>	<u>47</u>	<u>317</u>
Information upon completion of well:			
(1) Diameter <u>2</u> inches.			
(2) Total Depth <u>317</u> feet.			
(3) Water Level <u>174</u> feet below top of ground.			
(4) Cased to <u>317</u> , Size <u>2"</u>			
(5) Screen: Size <u>2"</u> , Length <u>5'</u>			
(6) Were any formations sealed against pollution? <u>no</u> yes, <u>no</u> no.			
If YES depth of formation _____			
Why _____			
Drillers Remarks: _____			
_____			
_____			
_____			

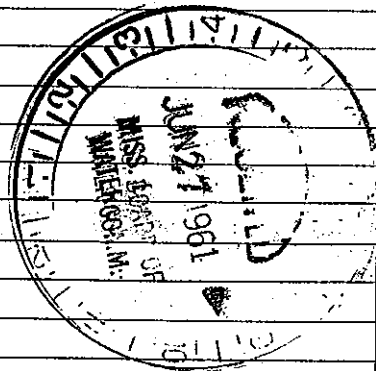

27

Well No.

(Use Back Side)

Mail this copy to Board of Water Commissioners 429 Miss. St. Jackson, Miss