

COUINGTON MISSISSIPPI BOARD OF WATER COMMISSIONERS

K11

12-12-61

WATER WELL DRILLERS LOG

Date: 12-12, 1961, Driller: HERMON PARKER County Couington  
 (Name)

	Description & Color of Materials Sand, Clay, Red Clay, Shell, etc.	Thick- ness Feet	Depth Feet
(1) Owner of Land: <u>RAY Blackwell</u> (Name) <u>SEMINARY, MISS</u> (Address)	<u>Blue CHALK</u>	<u>85</u>	<u>85</u>
(2) Location: _____ 1/4, _____ 1/4, Sec. <u>9</u> T. <u>R</u>	<u>SAND</u>	<u>33</u>	<u>118</u>
<u>0</u> miles <u>in town</u> , of <u>Seminary</u> . (distance) (direction) (Nearest Town)			
(3) Topography: <u>Level</u> (Hilly) (Flat) (Level)			
(4) Purpose of Well: <u>Domestic</u> (Domestic Irrigation Municipal, Industrial, Other)			


Information upon completion of well:

- (1) Diameter 2 inches.
- (2) Total Depth 118 feet.
- (3) Water Level 48 feet below top of ground.
- (4) Cased to 118, Size 2"
- (5) Screen: Size 2", Length 5'
- (6) Were any formations sealed against pollution?  
 yes,  no.

If YES depth of formation \_\_\_\_\_

Why \_\_\_\_\_

Drillers Remarks: \_\_\_\_\_

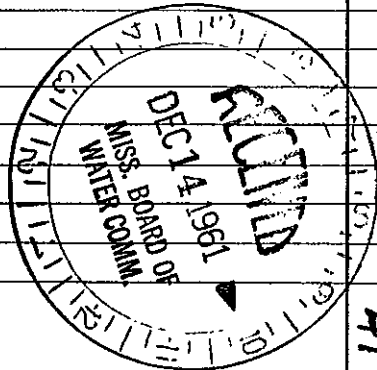

41 Well No.

(Use Back Side)