

G K12
8-31-63


WATER WELL DRILLERS LOG

Date: 8-31, 1963, Driller: Hermon Parker County Concrete
(Name)

(1) Owner of Land:	Description & Color of Materials Sandy Clay, Red Clay, Shell, etc.	Thick- ness Feet	Depth Feet
<u>James Kennedy</u> (Name)	<u>blue clay</u>	<u>30</u>	<u>30</u>
<u>Sen. Del. Collins</u> (Address)	<u>" Chalk</u>	<u>220</u>	<u>250</u>
(2) Location: <u>1/4</u> , <u>1/4</u> , Sec. <u>4</u> T <u>R</u>	<u>sand</u>	<u>72</u>	<u>322</u>
<u>1</u> miles <u>South</u> of <u>Collins</u> (distance) (direction) (Nearest Town)			
(3) Topography: <u>hilly</u> (Hilly) (Flat) (Level)			
(4) Purpose of Well: <u>domestic</u> (Domestic Irrigation Municipal, Industrial, Other)			

Information upon completion of well:

- (1) Diameter 2 inches.
- (2) Total Depth 322 feet.
- (3) Water Level 59 feet below top of ground.
- (4) Cased to 322, Size 2"
- (5) Screen: Size 2", Length 5'
- (6) Were any formations sealed against pollution?
no.

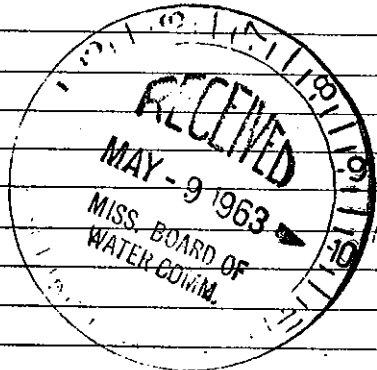

If YES depth of formation _____
Why _____
Drillers Remarks: _____

322
Well No. 52

(Use Back Side)