

COUINGTON MISSISSIPPI BOARD OF WATER COMMISSIONERS

K13

8-30-62

WATER WELL DRILLERS LOG

Date: 8-30, 1962, Driller: Herman Park county Couington  
 (Name)

(1) Owner of Land:	Description & Color of Materials Sand, Clay, Red Clay, Shell, etc.	Thick- ness Feet	Depth Feet
<u>John Dyles</u> (Name) <u>R.T. Seminary</u> (Address)	<u>Red Clay</u>	<u>26</u>	<u>26</u>
	<u>blue chalk</u>	<u>120</u>	<u>146</u>
	<u>sand</u>	<u>60</u>	<u>206</u>
(2) Location: <u>1/4</u> , <u>1/4</u> , Sec. <u>1</u> T. <u>1</u> R. <u>1</u>			
<u>3</u> miles <u>North</u> of <u>Seminary</u> (distance) (direction) (Nearest Town)			
(3) Topography: <u>level</u> (Hilly) (Flat) (Level)			
(4) Purpose of Well: <u>Domestic</u> (Domestic Irrigation Municipal, Industrial, Other)			


Information upon completion of well:

- (1) Diameter: 2 inches.
- (2) Total Depth: 206 feet.
- (3) Water Level: 81 feet below top of ground.
- (4) Cased to: 206, Size 2"
- (5) Screen: Size 2", Length 5'
- (6) Were any formations sealed against pollution?  
 yes,  no.

If YES depth of formation: \_\_\_\_\_

Why: \_\_\_\_\_

Drillers Remarks: \_\_\_\_\_

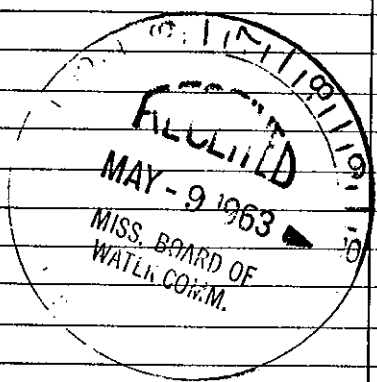

206

50 Well No.

(Use Back Side)