

COVINGTON

MISSISSIPPI BOARD OF WATER COMMISSIONERS

K 14

2-11-66

Date: 8/11

1966

Driller:

C. S. Clark

County:

Covington

WATER WELL DRILLERS LOG

CODED

(Name)


(1) Owner of Land:	Description & Color of Materials Sand, Clay, Red Clay, Shell, etc.	Thick- ness Feet	Depth Feet
James Kennedy (Name) Collins Miss Pt 1 (Address)	0-80 Clay	80	
2/4, 7/15 (Location)	80-94 Sandy Clay	14	
31 T 8 R 15 (Location)	94-201 Clay	107	
2 miles South of Collins (distance) (direction) (Nearest Town)	201-240 Sandy Strata	39	
(3) Topography:	240-372 Clay	132	
(Hilly) (Flat) (Level)	372-415 Sandy Clay	43	
(4) Purpose of Well:	415-430 Sand	15	
(Domestic Irrigation Municipal, Industrial, Other)			

Information upon completion of well:

- (1) Diameter 2 inches.
- (2) Total Depth 430 feet.
- (3) Water Level 85 feet below top of ground.
- (4) Cased to 410, Size 2
- (5) Screen: Size 1 1/4, Length 20 Brass
- (6) Were any formations sealed against pollution?  
 yes,  no.

CODED

If YES depth of formation 370 ft  
Why Real lumpy hot Clay  
Drillers Remarks:

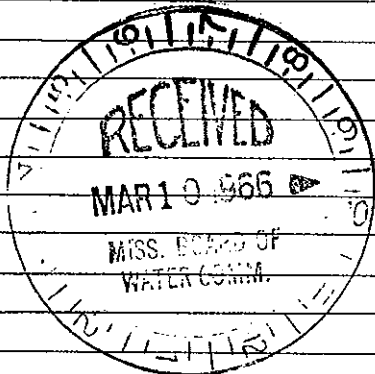

Well No.

(Use Back Side)

Mail this copy to Board of Water Commissioners 429 Miss. St. Jackson, Miss.