

MISSISSIPPI BOARD OF WATER COMMISSIONERS
COVINGTON

K15

9-20-63

Date: 9-20, 1963, Driller: H. J. Moxey County Jones

WATER WELL DRILLERS LOG CODED

	Description & Color of Materials Sand, Clay, Red Clay, Shell, etc.	Thick- ness Feet	Depth Feet
(1) Owner of Land: <u>Wilford Rogers</u> (Name) <u>Rt #1 Seminary, Miss</u> (Address)			
(2) Location: <u>1/4, 1/4, Sec 7 15</u> <u>8 7 R14</u> <u>2</u> miles <u>south</u> of <u>Seminole</u> (distance) (direction) (Nearest Town)	<u>Sand all</u> <u>way down to 154</u> <u>ft 10 ft</u>		
(3) Topography: <input checked="" type="checkbox"/> (Hilly) <input type="checkbox"/> (Flat) <input type="checkbox"/> (Level)	<u>good coarse white</u>		
(4) Purpose of Well: <u>Home</u> (Domestic Irrigation Municipal, Industrial, Other)	<u>sand.</u>		

Information upon completion of well:


- (1) Diameter 2" inches.
- (2) Total Depth 164 feet.
- (3) Water Level 120 feet below top of ground.
- (4) Cased to _____, Size _____.
- (5) Screen: Size 2", Length 5'.
- (6) Were any formations sealed against pollution?
_____ yes, _____ no.

If YES depth of formation _____

Why _____

Drillers Remarks: _____

CODED

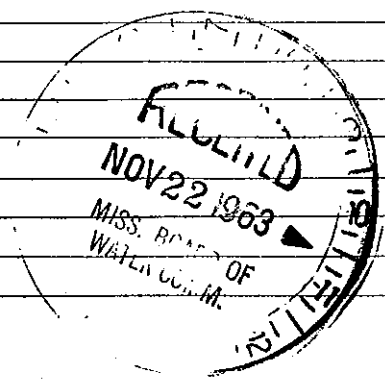

(Use Back Side)

Well No.