

COUINGTON
K 21
9-22-68

MISSISSIPPI
BOARD OF WATER COMMISSIONERS
416 North State Street
Jackson, Mississippi 39201

WATER WELL DRILLERS LOG


~~10-27~~ 1968 date well completed
Ray Villist firm name
Couington county well located

LANDOWNER	description of formations encountered	from	to
Jack Pace Rt 3	sandy clay	0	30
Seminary, Miss (mailing address)	clay	30	60
	sand	60	100

WELL LOCATION:
sec. 3 T. 7 N. R. 15 E.
S W
3 miles North of Seminary
(distance) (direction) (nearest town)

WELL PURPOSE: Home
(home, irrigation, municipal, industrial)

- WELL COMPLETION DATA:
- (1) diameter (inches) 2
 - (2) total depth (feet) 100
 - (3) static water level (feet) 65 below top of ground.
 - (4) casing Galv 90 (material) (depth)
 - (size) If telescope see back.
 - (5) screen 10 90 (length) (depth to top)
 - 14 Stainless (size) (material)
 - (6) pump 1 8 (HP) (yield gpm)
 - REA (type power)
 - (7) electric log NO (yes or no)
 - (organization running log)
 - (8) how well bottom plugged Wash

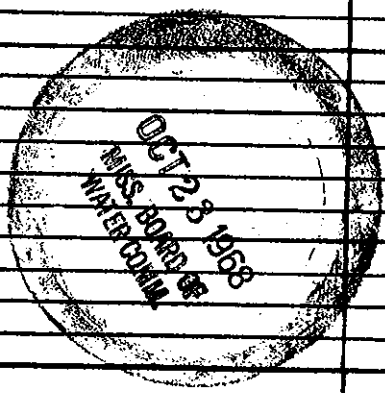

DRILLERS REMARKS: