State Well Report For Office Use Only:	
County: (JOU, ASTAR) Part 1	
Mississippi Department of Environmental Quality Aquiter:	<u></u>
Permit #: Office of Land and Water Resources Well #: $4-5.3$	
$\mathbf{F}_{\mathbf{M}}$	
Jackson, MS 39289-0031 L. S. Elevation:	
Date drilling completed: (601)961-5210 E-log #:	
(001)534-0930 (14X)	
State Law requires that this report be prepared by the driller in detail and filed with the Department with 30 days of completion of drilling of the well.	in
30 days of completion of drifting of the wen. Well Owner Information Well Location	
Ted Children Line 2 "Longitudes of the	,,
Owner NameJosh_ <u>Stringer</u> Latitude:'' Longitude:'	
Mailing Address: <u>Ben Rithens RL</u> Method of Lat/Long (circle one): Conventional Survey,	
Seminary MS USGS quad, Hand-held GPS, Survey-grade GPS	
1/4 1/4 Sec 24 Twn 7 N Rng 15	6
City State Zip Code	
Distance Direction Nearest Town Miles	
Well Data Pouttry	
Purpose of Well (circle one) Home Industrial Public Supply Irrigation Fish Culture Other Farm Supp	ly -
	/
Date well drilling started: $5/100$ Date well drilling completed: $5/5/00$	
If flowing, method of flow regulation: Valve Other (describe)	
Static Water Level: 105 feet above or below (circle one) land surface Date measured: 5/5/06	
	~
	/
Hole depth: $243'$ Well depth: $240'$ Well grouted to a depth of <u>50</u> feet	
Type of grout (circle one): Cement Bentonite Mix	
Casing length: <u>220</u> feet Casing diameter: <u>4</u> inches Type of casing: <u>PVC</u>	
Screen slot size: $0,000$ inches Setting depth: From 220 feet to 240 feet	
Type of completion (circle all applicable): Gravel packed Underreamed Telescoped Open hole Natural Development	ent
Other (describe):	
Top of lap pipe or reduction in casing:feet. If telescoped or more than one screen, describe on back of pa	ge
Logs run (circle all applicable). No log run Electric Gamma Ray Density Sonic Neutron Other:	
Norma of anoma institution manufactorial (a)	
Name of organization running log(s): I certify that the well was drilled, constructed, and completed in accordance with all applicable requirements of the Missi	sinni
	ולליניי
Department of Environmental Quality and/or the Mississippi Department of Health regulations and state laws.	
John W Thompson 0-679 John V. thenkon	
Print Name of Water Well Contractor and License No. Signature of Water Well Contractor	
REC	FIV
	0 1 20
BY: C)LV

-.


.

ų

1

ιî.

ŧ ŝ

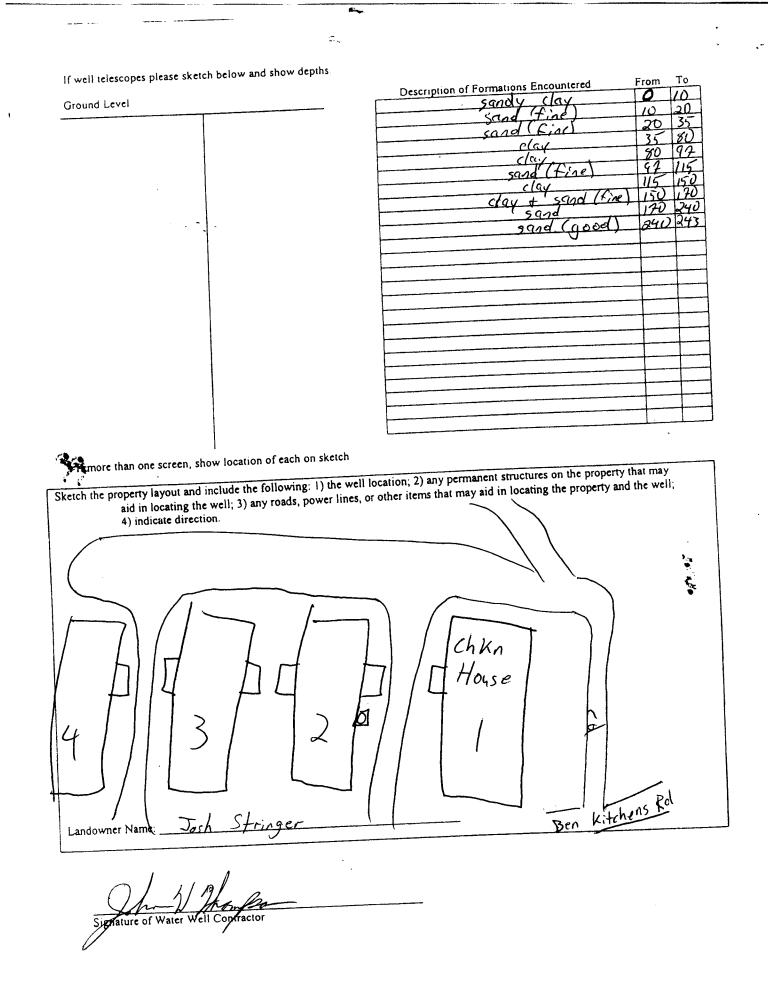

~...

· · ·			
STATE	E WELL REPORT		
County: <u>Coving ton</u> Pump Ins Permit #: Mississippi Dep	Part 2 staller's Completion Report partment of Environmental Quality Land and Water Resources P.O. Box 10631	For Office Use Only: Aquifer:	
Date completed: 5/05/05/ Jack	kson, MS 39289-0631 (601)961-5210 501)354-6938 (fax)	Well #: K-53 Elevation:	
This report should be prepared by the pump installer in installation of pump.	n detail and filed with the Departme	ent within 30 days of the	
Well Owner Information Owner Name: Josh Stringer		l Location	
Mailing Address: Ben Kitchens Rd		Longitude:	
Seminary MS City State Zip Code	<u> </u>	-held GPS, Survey-grade GPS <u>4</u> Twn <u>7</u> N Rng <u>15</u> <u>A</u> Nearest Town	
Telephone No. ()	Miles of	Seminary	
Pump Type Circle one		rer Type rele one	
Air Lift Jet Submersible Bucket Piston Turbine	Diesel Engine Gasoline		
Centrifugal Rotary Flowing Well	Electric Motor Hand Windmill Other (s		
Other (specify):	Horse Power Rating of Motor:		
Date Pump Installed:			
Rated Pump Capacity: <u>55</u> Gallons Per Minute	Number of Stages:	3	
Pump Test Data ate Well Tested:		Method of Measuring Water Level Circle one	
tatic Water Level (A): <u>107</u> Feet Below Land Surface umping Water Level (B): <u>117</u> Feet Below Land Surface		ring Line Steel Tape	
rawdown [(B) - (A)]:	For flowing well, measured shut	in head: feet	
est Pumping Rate: UD Gallons Per Minute			
uration of Pump Test (minimum 4 hours):hours		,	
HEREBY CERTIFY that the above statements are true to the bes John V. Thompson 0-679 int Name of Pump Installer and License No. (if applicable)	st of my knowledge.	1) Iler	

1

JUN 0 1 2006 BY: OLWR ŧ :