

COVINGTON
L 21
2-14-91

MISSISSIPPI DEPARTMENT OF NATURAL RESOURCES

Bureau of Land and Water Resources

Southport Mall

P.O. Box 10631

Jackson, Mississippi 39209

WATER WELL DRILLERS LOG

Griner Drilling Service, Inc.

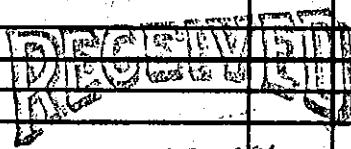
Covington

2-14-91
 date well completed

firm name

county well located

Lease; No. 1 D. Rushton

LANDOWNER:	description of formations encountered	from	to
(mailing address)			
<u>Oryx Energy Co.</u> <u>P. O. Box 219003</u> <u>Dallas, Texas</u>	<u>sand</u>	<u>0</u>	<u>65</u>
WELL LOCATION: <u>2670'S + 200'E</u> sec. <u>9</u> T. <u>7N</u> R. <u>14E</u> of <u>W Natchez</u> <u>East of Collins</u> (distance) (direction) (nearest town)	<u>clay</u>	<u>65</u>	<u>150</u>
WELL PURPOSE: <u>oilfield supply</u> (home, irrigation, municipal, industrial)	<u>sand</u> <u>pea gravel</u>	<u>150</u>	<u>225'</u>
WELL COMPLETION DATA:	<u>clay</u> <u>rock</u>	<u>225</u>	<u>240</u>
(1) diameter (inches) <u>4"</u>	 FEB 28 1991 Dept. of Environmental Quality Bureau of Land & Water Resources		
(2) total depth (feet) <u>240'</u>			
(3) static water level (feet) <u>125'</u> ^{below} _{above} top of ground.			
(4) casing <u>PVC, 205'</u> (material) (depth) <u>4"</u> (size) If telescope see back.			
(5) screen <u>20'</u> , <u>205' to 225'</u> (length) (depth to top) <u>4" PVC screen</u> (size) (material)			
(6) pump <u>7 1/2</u> , <u>40</u> (HP) (yield gpm) <u>440 volt 3 phase</u> (type power)			
(7) electric log <u>(yes or no)</u> <u>4" PVC backwash</u> (organization running log) <u>valve</u>			
(8) how well bottom plugged _____			
DRILLERS REMARKS: _____			