

03/10/2008 00:41 6014281435

A-1 DRILLING SERVICE

PAGE 01

EQ
3/10/08

State Well Report

Part 1

Mississippi Department of Environmental Quality
 Office of Land and Water Resources
 P.O. Box 10631
 Jackson, MS 39289-0631
 (601)961-5210
 (601)354-6938 (fax)

For Office Use Only:

Aquifer: _____
 Well #: L-36
 L. S. Elevation: _____
 E-log #: _____

County: COVINGTON
 Permit #: _____
 Driller: A-1 Drilling Serv, Inc.
 Date drilling completed: 3-6-08

State Law requires that this report be prepared by the driller in detail and filed with the Department within 30 days of completion of drilling of the well.

Well Owner Information	Well Location
Owner Name: <u>TROY CARTEE</u>	Latitude: <u>31°32'54"</u> Longitude: <u>89°29'56"</u>
Mailing Address: <u>506 SHIRLEY RD</u>	Method of Lat/Long (circle one): Conventional Survey.
<u>SEMINARY MS 39479</u>	<u>USGS quad</u> <u>Hand-held GPS</u> , Survey-grade GPS
City State Zip Code	<u>NW/NE/SE</u> Sec. <u>28</u> Twn <u>7N</u> Rng <u>14W</u>
Telephone No: <u>(601)722-4948</u>	Distance Direction Nearest Town
	<u>1.5</u> Miles <u>E-SE</u> of <u>SEMINARY</u>

Well Data

Purpose of Well (circle one) Home Industrial Public Supply Irrigation Fish Culture Other: _____

Date well drilling started: 3-5-08 Date well drilling completed: 3-6-08

If flowing, method of flow regulation: Valve — Other (describe) _____

Static Water Level: 129 feet above or below (circle one) land surface Date measured: 3-7-08

Method of Measurement (circle one) steel tape electric tape air line other: Sonic

Hole depth: 191' Well depth: 190' Well grouted to a depth of 14 feet

Type of grout (circle one): Cement Bentonite Mix

Casing length: 181 feet Casing diameter: 4 inches Type of casing: PVC

Screen length: 10 feet Screen diameter: 4 inches Type of screen: PVC

Screen slot size: .006 inches Setting depth: From 180 feet to 190 feet

Type of completion (circle all applicable): Gravel packed Underreamed Telescoped Open hole Natural Development

Other (describe): _____

Top of lap pipe or reduction in casing: NA feet. If telescoped or more than one screen, describe on back of page

Logs run (circle all applicable) No log run Electric Gamma Ray Density Sonic Neutron Other: _____

Name of organization running log(s): _____

I certify that the well was drilled, constructed, and completed in accordance with all applicable requirements of the Mississippi Department of Environmental Quality and/or the Mississippi Department of Health regulations and state laws.

Wilbur T. Baughman 0410
 Print Name of Water Well Contractor and License No.

[Signature]
 Signature of Water Well Contractor

03/10/2008 00:41 6014281435

A-1 DRILLING SERVICE


PAGE 02

L - 36

100-00
*0-00

If well telescopes please sketch below and show depths.

Ground Level

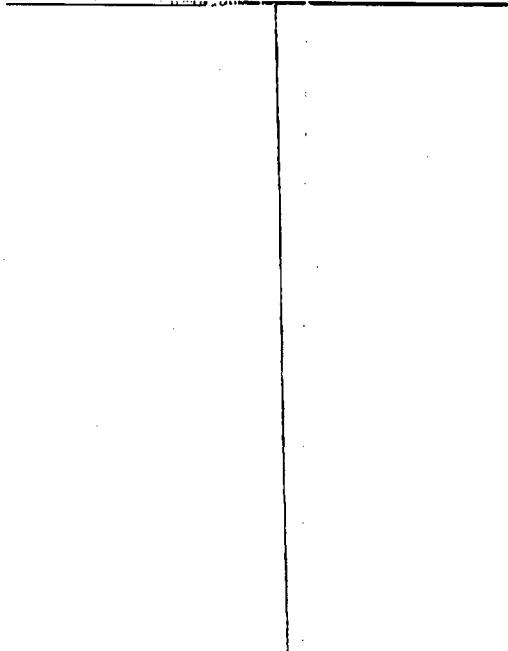

Description of Formations Encountered

From To

Description of Formations Encountered	From	To
Clay, red, sandy	0	22
Clay w/ streaks sand, yellow	22	28
Clay, tan, stiff	28	86
Clay, sandy, red	86	101
Sand, red, med	101	134
Sand & clay mixed	134	139
Sand, coarse, sm. pea gravel	139	190
Clay	190	191

If more than one screen, show location of each on sketch

Sketch the property layout and include the following: 1) the well location; 2) any permanent structures on the property that may aid in locating the well; 3) any roads, power lines, or other items that may aid in locating the property and the well; 4) indicate direction.

Landowner Name: TROY CARTEE

Albert C. ...
Signature of Water Well Contractor

DEQ
3-10-08

STATE WELL REPORT

Part 2

Pump Installer's Completion Report
 Mississippi Department of Environmental Quality
 Office of Land and Water Resources
 P.O. Box 10631
 Jackson, MS 39289-0631
 (601)961-5210
 (601)354-6938 (fax)

County: Covington
 Permit #: _____
 Driller: A-1 Drilling Service, Inc
 Date completed: 3-7-08

For Office Use Only:
 Aquifer: _____
 Well #: L-36
 Elevation: _____

This report should be prepared by the pump installer in detail and filed with the Department within 30 days of the installation of pump.

Well Owner Information	Well Location
Owner Name: <u>TROY CARTER</u>	Latitude: <u>31°32'54"</u> Longitude: <u>89°24'56"</u>
Mailing Address: <u>506 SHIRLEY RD</u>	Method of Lat/Long (circle one): Conventional Survey,
<u>SEMINARY MS 39479</u>	<u>USGS quad</u> <u>Hand-held GPS</u> , Survey-grade GPS
City State Zip Code	<u>NW/14SE</u> 1/4 Sec <u>28</u> Twn <u>7N</u> Rng <u>14W</u>
Telephone No. <u>(601) 772-4948</u>	Distance Direction Nearest Town
	<u>± 5</u> Miles <u>ESE</u> of <u>SEMINARY</u>

Pump Type Circle one	Power Type Circle one
Air Lift Jet <u>Submersible</u>	Diesel Engine Gasoline Engine Natural Gas
Bucket Piston Turbine	<u>Electric Motor</u> Hand Tractor PTO
Centrifugal Rotary Flowing Well	Windmill Other (specify): _____
Other (specify): _____	Horse Power Rating of Motor: <u>2</u>
Date Pump Installed: <u>3-7-08</u>	Setting Depth: <u>161</u> feet
Rated Pump Capacity: <u>8</u> Gallons Per Minute	Number of Stages: <u>14</u>

Pump Test Data	Method of Measuring Water Level Circle one
Date Well Tested: _____	Air Line Electric Measuring Line Steel Tape
Static Water Level (A): <u>129</u> Feet Below Land Surface	Other (specify): <u>SONIC</u>
Pumping Water Level (B): _____ Feet Below Land Surface	For flowing well, measured shut in head: _____ feet
Drawdown [(B) - (A)]: _____ Feet Below Land Surface	Well yielded _____ GPM with a drawdown of _____ feet after _____ hours of pumping
Test Pumping Rate: _____ Gallons Per Minute	
Duration of Pump Test (minimum 4 hours): _____ hours	

I HEREBY CERTIFY that the above statements are true to the best of my knowledge.

Wilbur T. Baughman 0410 _____
 Print Name of Pump Installer and License No. (if applicable) Signature of Pump Installer