

COVINGTON MISSISSIPPI BOARD OF WATER COMMISSIONERS

MB


7-21-61

WATER WELL DRILLERS LOG

M 301

Date: 7-21, 1961, Driller: HERMON PARKER County: Covington
(Name)

(1) Owner of Land	Description & Color of Materials Sand, Clay, Red Clay, Shell, etc.	Thick- ness Feet	Depth Feet
<u>W. J. FEIKES</u> <small>(Name)</small> <u>Rt. 2 Seminary, Miss</u> <small>(Address)</small>	<u>Red CHALK</u> <u>Red SAND</u>	<u>65</u> <u>30</u>	<u>65</u> <u>95</u>
(2) Location: <u>1/4</u> , <u>1/4</u> , Sec. <u>11</u> T <u>R</u>			
<u>3</u> miles <u>West</u> , at <u>Sawford</u> <small>(distance) (direction) (Nearest Town)</small>			
(3) Topography: <u>FIAT</u> <small>(Hilly) (Flat) (Level)</small>			
(4) Purpose of Well: <u>Domestic</u> <small>(Domestic Irrigation Municipal, Industrial, Other)</small>			
Information upon completion of well:			
(1) Diameter <u>2</u> inches.			
(2) Total Depth <u>95</u> feet.			
(3) Water Level <u>78</u> feet below top of ground.			
(4) Cased to <u>95'</u> , Size <u>2"</u>			
(5) Screen: Size <u>1"</u> , Length <u>5'</u>			
(6) Were any formations sealed against pollution? <u>no</u> yes, <u>NO</u> no.			
If YES depth of formation _____			
Why _____			
Drillers Remarks: _____			

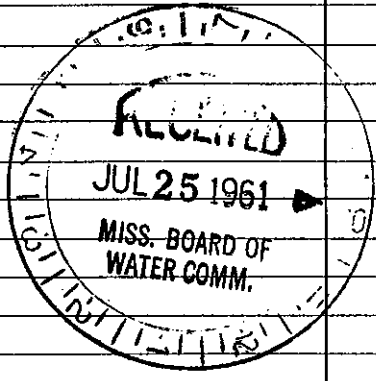

30

Well No.

(Use Back Side)

Mail this copy to Board of Water Commissioners 429 Miss. St. Jackson, Miss