

COVINGTON MISSISSIPPI BOARD OF WATER COMMISSIONERS

M 9

WATER WELL DRILLERS LOG

7-7-62

Date: 7-7, 1962, Driller: Hermon Perber County Covington

(Name)

(1) Owner of Land	Description & Color of Materials Sand, Clay, Red Clay, Shell, etc.	Thick- ness Feet	Depth Feet
M. P. Singrich (Name) Rt. 2 Seminary (Address)	Red Clay Sand	61 3091	61 61
(2) Location: 1/4, 1/4, Sec 11 T. R.			
6 miles South of Seminary (distance) (direction) (Nearest Town)			
(3) Topography: Hilly (Hilly) (Flat) (Level)			
(4) Purpose of Well: Domestic (Domestic Irrigation Municipal, Industrial, Other)			


Information upon completion of well:

- (1) Diameter 2 inches.
- (2) Total Depth 91 feet.
- (3) Water Level 61 feet below top of ground.
- (4) Cased to 91, Size 2"
- (5) Screen: Size 2", Length 5'
- (6) Were any formations sealed against pollution?
 yes, no.

If YES depth of formation _____

Why _____

Drillers Remarks: _____

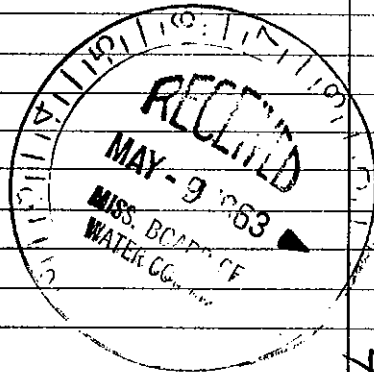

91

47

Well No.

(Use Back Side)

Mail this copy to Board of Water Commissioners 429 Miss. St. Jackson, Mis