

COVINGTON

M10

10-3-62

Date: 10-3, 1962, Driller: Herman Parker County Covington

WATER WELL DRILLING LOG

(Name)

(1) Owner of Land:	Description & Color of Materials Sand, Clay, Red Clay, Shell, etc.	Thick- ness Feet	Depth Feet
Mrs. Anette Reeves (Name) P.O. 3 Seminary (Address)	Red Clay blue Chalk Sand	40 30 50	40 70 120
(2) Location: 1/4, 1/4, Sec. 11 T. R.			
6 miles S. West Seminary (distance) (direction) (Nearest Town)			
(3) Topography: Flat (Hilly) (Flat) (Level)			
(4) Purpose of Well: Domestic (Domestic Irrigation Municipal, Industrial, Other)			


Information upon completion of well:

- (1) Diameter 2 inches.
- (2) Total Depth 120 feet.
- (3) Water Level 65 feet below top of ground.
- (4) Cased to 120', Size 2"
- (5) Screen: Size 2", Length 5'
- (6) Were any formations sealed against pollution?
yes, no.

If YES depth of formation

Why

Drillers Remarks:

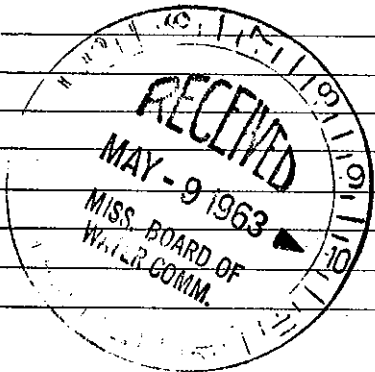

120

53

Well No.

(Use Back Side)

Mail this copy to Board of Water Commissioners 429 Miss. St. Jackson, Miss