

COVINGTON MISSISSIPPI BOARD OF WATER COMMISSIONERS

M12


WATER WELL DRILLERS LOG

CODED

8-8-63

Date: 8-8, 1963, Driller: Jay Latt County Covington
(Name)

(1) Owner of Land:	Description & Color of Materials Sand, Clay, Red Clay, Shell, etc.	Thick- ness Feet	Depth Feet
<u>New Hope Baptist</u> <u>pastors home Church</u> <u>Sumrall, Miss.</u> <small>(Address)</small>	<u>0 - 8 yellow clay</u>		
(2) Location: <u>20 6 15</u>	<u>8 - 30 white sand</u>		
<u>1/4, 1/4, Sec. 12 T6 R16,</u>	<u>30 - 35 yellow sand</u>		
<u>5 miles</u> <u>n</u> , of <u>Sumrall</u>	<u>35 - 50 white sand</u>		
<small>(distance) (direction) (Nearest Town)</small>	<u>50 - 70 yellow clay</u>		
(3) Topography: <input checked="" type="checkbox"/> (Level)	<u>70 - 110 white sand</u>		
(4) Purpose of Well: <u>domestic</u> <small>(Domestic Irrigation Municipal, Industrial, Other)</small>	CODED		
Information upon completion of well:			
(1) Diameter <u>2</u> inches.			
(2) Total Depth <u>110</u> feet.			
(3) Water Level <u>12 1/2</u> feet below top of ground.			
(4) Cased to _____, Size _____			
(5) Screen: Size <u>2 in.</u> , Length <u>10 ft.</u>			
(6) Were any formations sealed against pollution? <u>no</u>			
If YES depth of formation _____			
Why _____			
Drillers Remarks: _____			

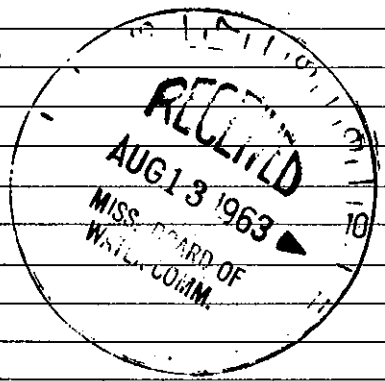

(Use Back Side)

Well No.

Mail this copy to Board of Water Commissioners 429 Miss. St. Jackson, Miss.