

COVINGTON

M 13

MISSISSIPPI BOARD OF WATER COMMISSIONERS

6-3-66

WATER WELL DRILLERS LOG

S. J. R. Drilling

Date: 6/3, 1966, Driller: Home County: Covington

(Name)

(1) Owner of Land: R. J. Coats  
 (Name)  
Rt 1 Sumrall, Miss  
 (Address)

(2) Location: SW 1/4, SW 1/4, Sec 28 T6 R15, N W  
 (distance) 3 1/2 miles NE (direction) of Sumrall (Nearest Town)

(3) Topography: Hilly  
 (Hilly) (Flat) (Level)

(4) Purpose of Well: Home  
 (Domestic Irrigation  
 Municipal, Industrial, Other)

Description & Color of Materials Sand, Clay, Red Clay, Shell, etc.	Thick- ness Feet	Depth Feet
<u>Red Clay</u>	<u>8</u>	<u>8</u>
<u>Clay Shale</u>	<u>9</u>	<u>17</u>
<u>Yellow Sand</u>	<u>8</u>	<u>25</u>
<u>White Sand</u>	<u>40</u>	<u>65</u>

Information upon completion of well:

(1) Diameter 2 inches.

(2) Total Depth 65 feet.

(3) Water Level 30 feet below top of ground.

(4) Cased to 60, Size 2"


(5) Screen: Size 2", Length 5 ft

(6) Were any formations sealed against pollution?  
 \_\_\_\_\_ yes,  no.

If YES depth of formation \_\_\_\_\_

Why \_\_\_\_\_

Drillers Remarks: \_\_\_\_\_

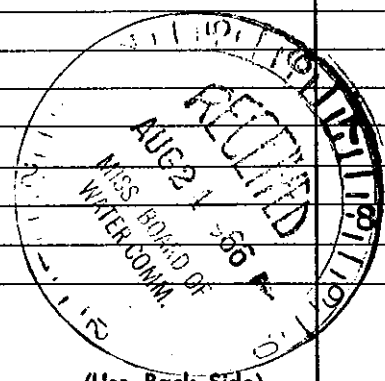

(Use Back Side)

Well No. 115

Mail this copy to Board of Water Commissioners 429 Miss. St. Jackson, Miss