

1192

Need part 2 12/12/17

County: Covington  
 Permit #: \_\_\_\_\_  
 Driller: John W Thompson  
 Date drilling completed: 6-5-17

### STATE WELL REPORT

#### Part 1

#### Driller's Log

Mississippi Department of Environmental Quality  
 Office of Land and Water Resources  
 P.O. Box 2309  
 Jackson, MS 39225-2309  
 (601)961-5210  
 (601)360-0535 (fax)

**For Office Use Only:**  
 Well #: M103  
 Aquifer: \_\_\_\_\_  
 E-Log #: \_\_\_\_\_

RECEIVED  
 JUN 19 2017  
 BY OLWR

*State Law requires that this report be prepared by the license holder responsible for the work and filed with the Department at the above address within 30 days of completion of drilling of the well or borehole.*

| Well Owner Information<br><small>(Landowner if borehole is not for a water well)</small> | Well or Borehole Location   |
|--|---|
| Owner Name: <u>Ernest Pittman</u>  | Latitude: <u>31° 26' 29.1"</u> Longitude: <u>89° 34' 33.0"</u>  |
| Mailing Address: <u>229 Everett Drennan</u><br><u>Sumrall MS 39482</u>                   | Method of Lat/Long (check one): Conventional Survey _____<br>USGS quad _____, Hand-held GPS _____, Survey-grade GPS _____ |
| City _____ State _____ Zip Code _____  | <u>SW</u> $\frac{1}{4}$ <u>NE</u> $\frac{1}{4}$ , Sec <u>35</u> T <u>6N</u> R <u>16W</u>                                  |
| Telephone No. (____) _____   | <u>2</u> Miles <u>NW</u> of <u>Sumrall</u><br>(Distance) (Direction) (Nearest Town)                                       |

**Well / Borehole Data**

Date drilling started: 6-2-17 Date drilling completed: 6-5-17 Hole depth: 80 Hole diameter: 80

Location of the source of any surface water used for drilling: Creek

Method of dosing and volume of Chlorine used in drilling and development: added 6 gallon bleach

Logs run (circle all applicable):  No log run  Electric  Gamma Ray  Density  Sonic  Neutron  Other: \_\_\_\_\_

Name of organization running log(s): \_\_\_\_\_

Purpose of borehole (circle one):  Water Well  Geotechnical/Geological Investigation  Ground Source Heat Pump  
 Seismic Survey  Other (describe) \_\_\_\_\_

*If drilling is not related to water well construction, skip the remainder of this block*

Purpose of Well (circle all applicable): Home  Industrial  Public Supply  Irrigation  Fish Culture

Other (describe): Poultry

If a flowing well, method of flow regulation: Valve \_\_\_\_\_ Other (describe) \_\_\_\_\_

Static Water Level: 30 feet [above or below] land surface Date measured: 6-5-17  
(circle one)

Method of measurement (circle one): Steel tape   Electric tape  Air line  Other (describe): \_\_\_\_\_

Well depth: 80 Well grouted to a depth of: 50 feet Type of grout (circle one): Neat Cement   Bentonite  Mix

Casing length: 60 feet Casing diameter: 4 inches Type of casing: PVC

Screen length: 20 feet Screen diameter: 4 inches Type of screen: PVC slotted

Screen slot size: .008 inches Setting depth: From 60 feet to 80 feet

Type of completion (circle all applicable): Gravel packed  Underreamed  Open hole  Natural Development

Other (describe): \_\_\_\_\_

Top of lap pipe or reduction in casing: \_\_\_\_\_ feet

*If telescoped or more than one screen, describe on next page*

County: Covington  
Permit #: \_\_\_\_\_

**For Office Use Only:**  
Well #: M103

**The sketch below only required for water wells**

**If well telescopes, show depths on sketch.**

Ground Level 

**Description of formations encountered must be provided for all wells and boreholes, unless specifically exempted by regulations**

| Description of Formations Encountered | From (depth) | To (depth) |
|---------------------------------------|--------------|------------|
| red sandy clay                        | Ground level | 15         |
| Sand                                  | 15           | 70         |
| sand + gravel                         | 70           | 78         |
| Clay                                  | 78           | 80         |
|                                       |              |            |
|                                       |              |            |
BYOLWR

RECEIVED  
JUN 19 2017

If more than one screen, show location of each on sketch

Sketch the property layout and include the following:

- 1) the well location
- 2) any permanent structures on the property that may aid in locating the well
- 3) any roads, power lines, or other items that may aid in locating the property and the well
- 4) north arrow


Landowner Name: \_\_\_\_\_

I HEREBY CERTIFY that the well/borehole was drilled, constructed, and completed in accordance with all applicable requirements of the Mississippi Department of Environmental Quality and the Mississippi Department of Health regulations, if applicable, and state laws.


Ernest Pittman 0-679     6-19-17     John W. Stompe  
Print Name of Responsible Licensee and License No.     Date     Signature of Licensee

M103

RECEIVED  
Google Maps  
JUN 19 2017  
BY OLWRP-31°26'29.1"N 89°34'33.0"W

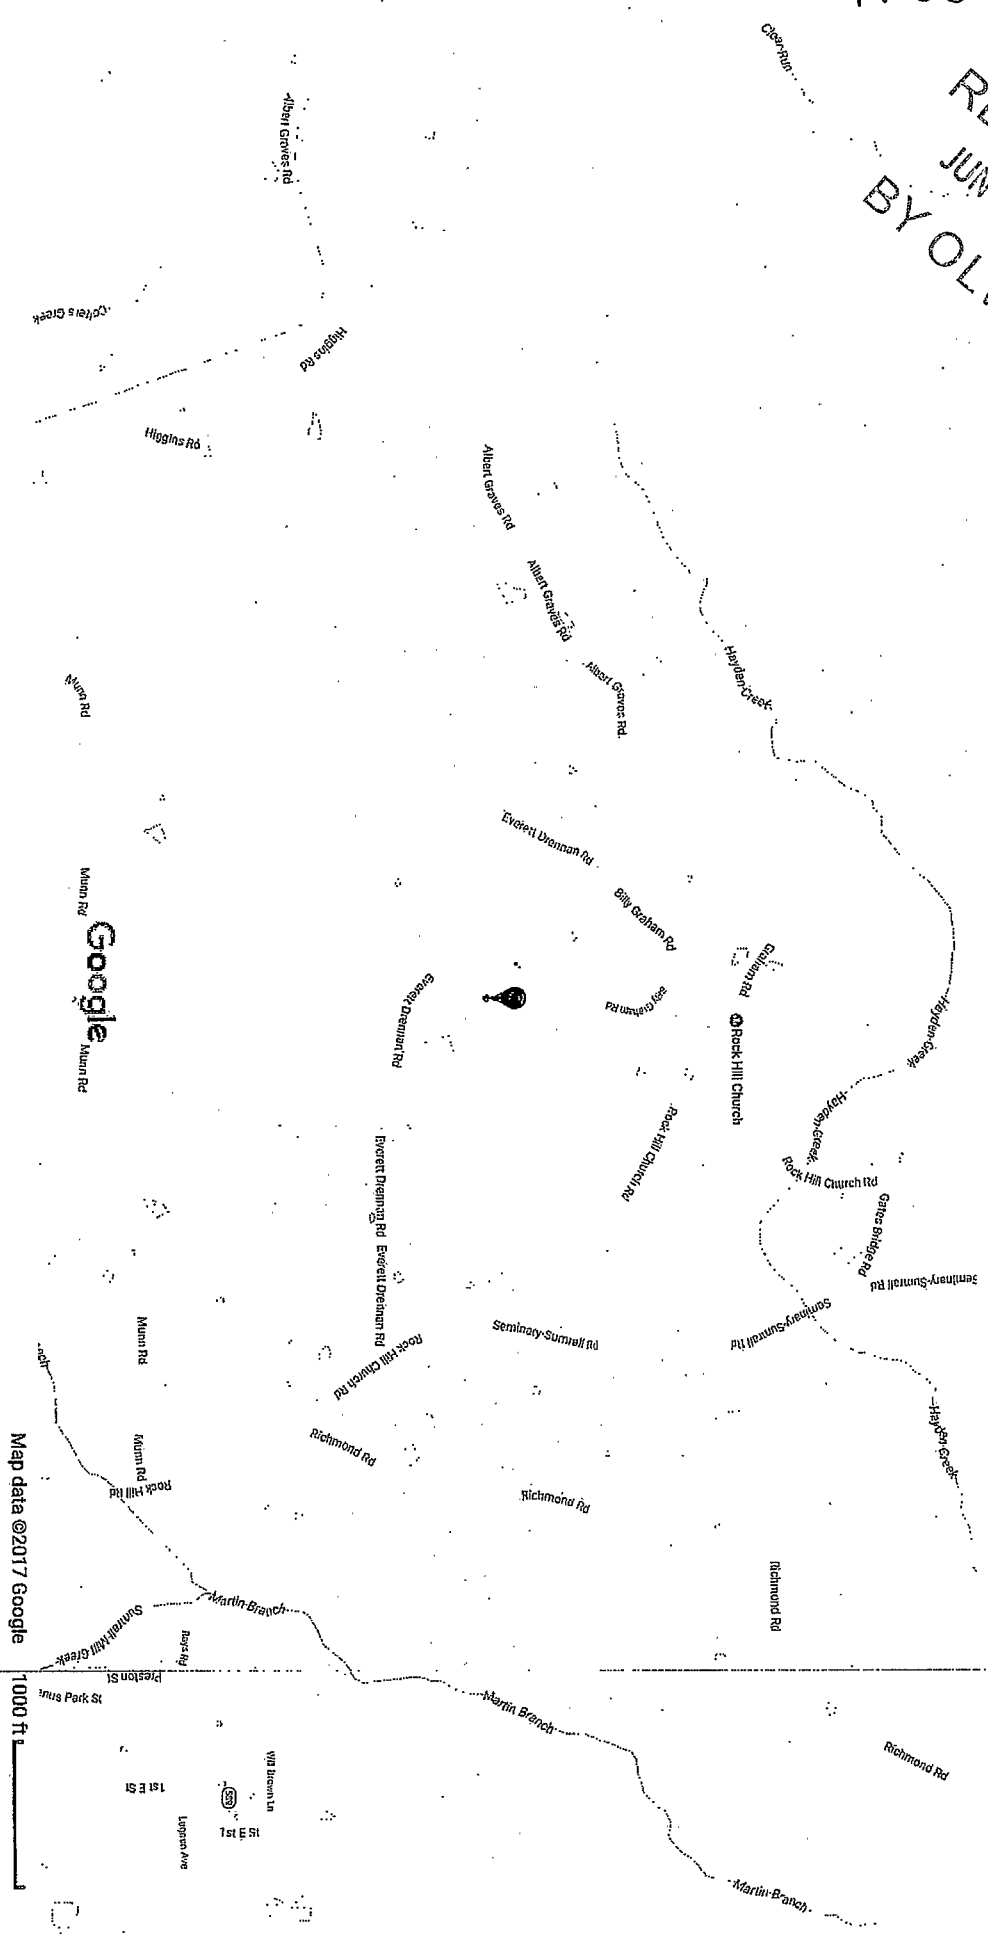

Google Maps 31°26'29.1"N 89°34'33.0"W

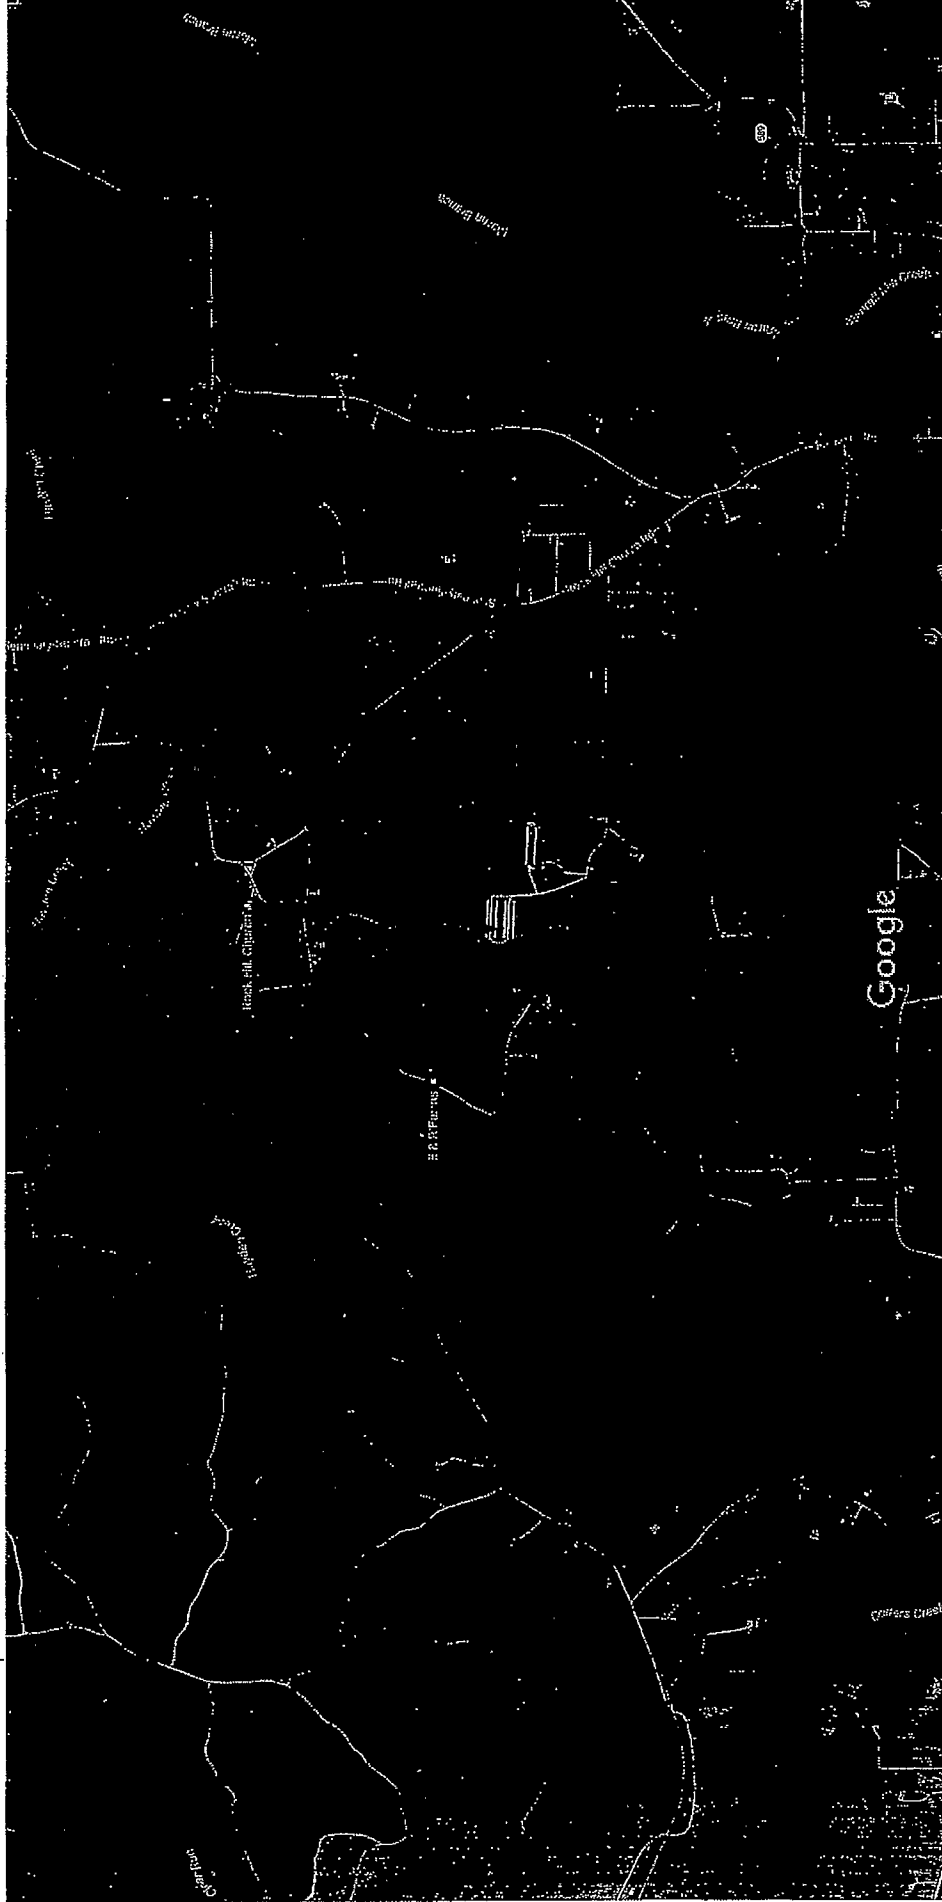

Imagery ©2017 DigitalGlobe, USDA Farm Service Agency, Map data ©2017 Google 1000 ft

