

MISSISSIPPI BOARD OF WATER COMMISSIONERS
COVINGTON
N6
WATER WELL DRILLERS LOG A 300


11-15-60
 Date: 11/15, 1960, Driller: Tims County Forest
(Name)

	Description & Color of Materials Sand, Clay, Red Clay, Shell, etc.	Thick- ness Feet	Depth Feet
(1) Owner of Land: <u>EE Hudson</u> <small>(Name)</small>	<u>Clay 0-40</u> <u>Sand + gravel 40-96</u>		
<u>1406 N. Main St. Hattiesburg, Miss.</u> <small>(Address)</small>			
(2) Location: <u>SE 1/4, SW 1/4, Sec. 4 T5 R14 West</u> <u>10 miles North</u> of <u>Hattiesburg</u> <small>(Distance) (direction) (Nearest Town)</small>			
(3) Topography: <u>Hilly</u> <small>(Hilly) (Flat) (Level)</small>			
(4) Purpose of Well: <u>Domestic</u> <small>(Domestic Irrigation, Municipal, Industrial, Other)</small>			

Information upon completion of well:

- (1) Diameter 2 inches.
- (2) Total Depth 96 feet.
- (3) Water Level 65 feet below top of ground.
- (4) Cased to 91 ft, Size 2"
- (5) Screen: Size 2", Length 5 ft
- (6) Were any formations sealed against pollution?
 yes, no.

If YES depth of formation _____
 Why _____
 Drillers Remarks: _____

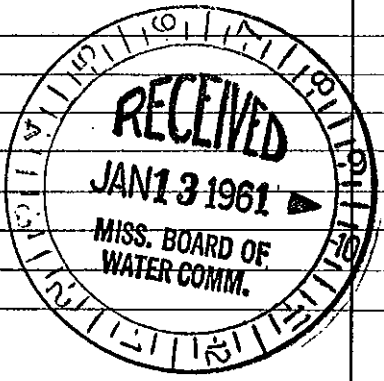

(Use Back Side)