

A // 10-29-60

A-300

WATER WELL DRILLERS LOG

Date: Oct. 29, 19 60, Driller: Deep South Well Drilling Co., (Name) JODED, County Desoto

(1) Owner of Land: Sacred Heart Church (Name)	Description & Color of Materials Sand, Clay, Red Clay, Shell, etc.	Thick- ness Feet	Depth Feet
Walls, Miss. (Address)	0-4 Surface clay	4	
(2) Location: 1/4, 1/4, Sec. 33 T 1 R 9,	4-18 Sandy Clay	14	
_____ miles _____, of Walls, Miss. (distance) (direction) (Nearest Town)	18-35 Med. Sand	17	
(3) Topography: Flat (Hilly) (Flat) (Level)	35-40 Coarse Sand	5	
(4) Purpose of Well: Church Rectory (Domestic Irrigation Municipal, Industrial, Other)			

CODED

Information upon completion of well:

(1) Diameter 2 inches.

(2) Total Depth 40 feet.

(3) Water Level 18 feet below top of ground.

(4) Cased to None, Size None.


(5) Screen: Size 1 1/4", Length 6 ft.

(6) Were any formations sealed against pollution?  
 \_\_\_\_\_ yes,  no.

If YES depth of formation \_\_\_\_\_

Why \_\_\_\_\_

Drillers Remarks: \_\_\_\_\_

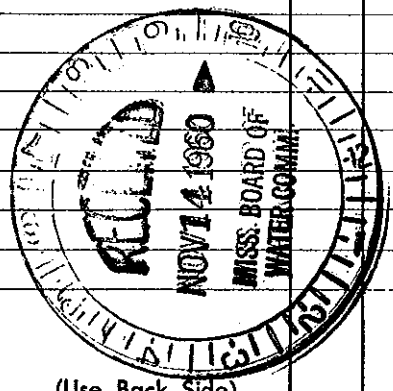

Well No.

(Use Back Side)