

Desoto

A-21

9-19-60

Date: 9-19-1960

Driller: C. B. Perry

(Name)

WATER WELL DRILLERS LOG

CODED

A or B-

(1) Owner of Land:	Description & Color of Materials Sand, Clay, Red Clay, Shell, etc.	Thick- ness Feet	Depth Feet
E. F. Crenshaw (Name)	0-30 ft		
#301 Hwy 5 mi SW of Stamps (Address)	Red Clay		
(2) Location: NE SE NW 1/4, 1/4, Sec. 18, 19, 20, 1 R. 8, 29 1 9	30-42 sand & gravel		
8 miles SW of MEMPHIS (distance) (direction) (Nearest Town)			
(3) Topography: <input checked="" type="checkbox"/> (Hilly) <input type="checkbox"/> (Flat) <input type="checkbox"/> (Level)			
(4) Purpose of Well: Domestic (Domestic Irrigation Municipal, Industrial, Other)			


Information upon completion of well:

- (1) Diameter 2 inches.
- (2) Total Depth 42 feet.
- (3) Water Level 9 feet below top of ground.
- (4) Cased to 38, Size 2
- (5) Screen: Size 1 1/4, Length 4 ft
- (6) Were any formations sealed against pollution?
 yes, no.

If YES depth of formation 3 ft to surface
Why GENERAL PRACTICE

Drillers Remarks:

CODED

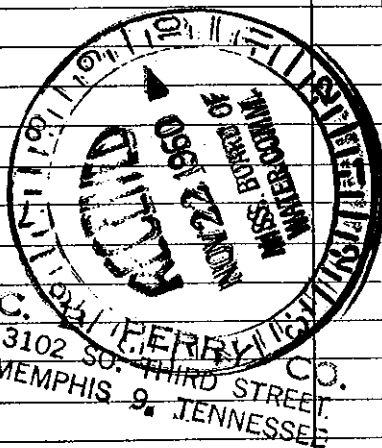

Well No. 2

(Use Back Side)

Mail this copy to Board of Water Commissioners 429 Miss. St. Jackson, Miss