

Note: this well has been taken over by walls W.A.

Pat 7/02

WATER WELL DRILLERS LOG

DESOTO

Date: 8-6-1963, Driller: C. B. Perry, O. A. A. 24
(Name)

CODED


	Description & Color of Materials Sand, Clay, Red Clay, Shell, etc.	Thick- ness Feet	Depth Feet
(1) Owner of Land: <u>Jack Adams</u> <small>(Name)</small> <u>walls Miss</u> <small>(Address)</small>	0 to 41 ft Clay		
(2) Location: $\frac{1}{4}$, $\frac{1}{4}$ Sec. <u>25 T. 1 R. 9</u> <u>(Synchburg)</u> <u>2 miles East</u> of <u>walls</u> <small>(distance) (direction) (Nearest Town)</small>	41 - 50 sandy Clay		
(3) Topography: <u>hilly</u> <small>(Hilly) (Flat) (Level)</small>	50 - 72 gravelly sand		
(4) Purpose of Well: <u>to fill lake</u> <small>(Domestic, Irrigation, Municipal, Industrial, Other)</small>	72 - 79 Coarse gravel		
	79 - 90 sand + gravel		
	90 - 99 sandy Clay		
	99 - 249 blue Gumbo		
	249 - 252 fine sand		
	252 - 254 Gumbo		
	254 - 255 fine sand		
	255 - 256 Gumbo		
	256 - 305 fine sand		
	305 - 318 medium sand		
	318 - 349 coarse sand		

Information upon completion of well:

- (1) Diameter 8 inches.
- (2) Total Depth 349 feet.
- (3) Water Level 91 feet below top of ground.
- (4) Cased to 329, Size 8
- (5) Screen: Size 6" ID, Length 20'
- (6) Were any formations sealed against pollution?
 yes, no.

CODED

If YES depth of formation Clay puddled from surface
 Why General Practice
 Drillers Remarks: did not drill to bottom of sand.

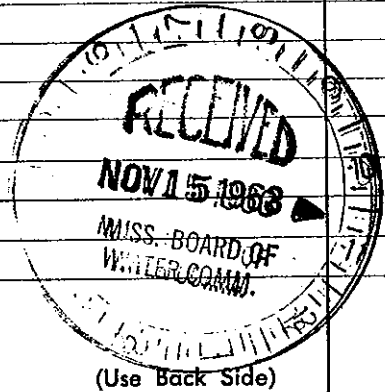

Well No.

Mail this copy to Board of Water Commissioners 429 Miss. St. Jackson, Miss