

Desoto
A27
9/67

MISSISSIPPI
BOARD OF WATER COMMISSIONERS
416 North State Street
Jackson, Mississippi 39201

CODED

WATER WELL DRILLERS LOG

Desoto
Mississippi

9-5-67 date well completed
Watson Co. firm name
Desoto county well located

LANDOWNER: Shelter Blythe
Lake Cormorant,
Miss.
(mailing address)


| description of formations encountered | from | to |
|---------------------------------------|------|----|
| Sandy loam | 0 | 12 |
| Med. Sand | 12 | 35 |
| Med. Coarse Sand | 35 | 55 |
| Med. Sand | 55 | 75 |
| Coarse Sand some gravel | 75 | 93 |

WELL LOCATION:
sec 36 T 1 N R 10 E
S W
4 miles W of Walls
(distance) (direction) (nearest town)

WELL PURPOSE: Farm Home
(home, irrigation, municipal, industrial)

- WELL COMPLETION DATA:
- (1) diameter (inches) 3"
 - (2) total depth (feet) 92' 11"
 - (3) static water level (feet) 19' 8" below top of ground.
 - (4) casing galv. pipe 84' 2" (material) (depth)
if telescope see back. (size)
 - (5) screen 8' 9" (length) (depth to top)
#60 Barge Point (size) (material)
 - (6) pump Jet (HP) (yield gpm)
(type power)
 - (7) electric log (yes or no)
(organization running log)
 - (8) how well bottom plugged

CODED

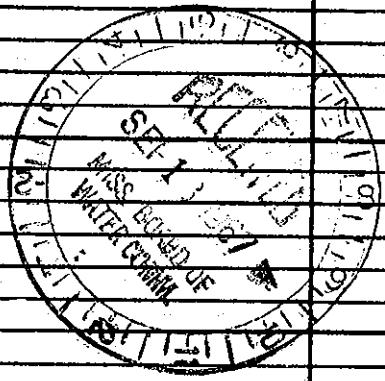

DRILLERS REMARKS: