

Desoto
A 28
2-68

MISSISSIPPI
BOARD OF WATER COMMISSIONERS
416 North State Street
Jackson, Mississippi 39201

CODED

WATER WELL DRILLERS LOG

2/19/68 C.B. PERRY CO DESOTA
date well completed firm name county well located

LANDOWNER: MRS. BRITT HUGHEY
RT 1 BOX 70
WALLS MISS 38680
(mailing address)


description of formations encountered	from	to
CLAY	0	32
GRAVEL + SAND	52	62
SAND	62	66

WELL LOCATION:
sec. 36 T. 1 N. R. 9 E.
2 miles S of WALLS
(distance) (direction) (nearest town)

WELL PURPOSE: HOME
(home, irrigation, municipal, industrial)

CODED

- WELL COMPLETION DATA:
- (1) diameter (inches) 2"
 - (2) total depth (feet) 66'
 - (3) static water level (feet) 40 below top of ground.
 - (4) casing GALV. STEEL, 62' (material), (depth)
 - (size) If telescope see back.
 - (5) screen 4', 62 (length), (depth to top)
 - (size) (material)
 - (6) pump 1/2 (HP), 6 (yield gpm)
ELEC (type power)
 - (7) electric log no (yes or no)
MO (organization running log)
 - (8) how well bottom plugged STEEL

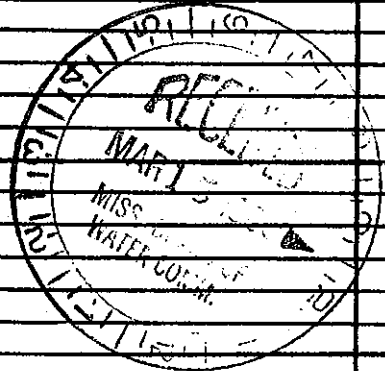

DRILLERS REMARKS: