

DeSoto MISSISSIPPI BOARD OF WATER COMMISSIONERS


A 2001
8-5-61

WATER WELL DRILLERS LOG

A 072

Date: Aug. 5, 19 61, Driller: Deep South Well Co. County DeSoto
(Name)

	Description & Color of Materials Sand, Clay, Red Clay, Shell, etc.	Thick- ness Feet	Depth Feet
(1) Owner of Land: <u>A. C. Hassell</u> (Name) <u>Horn Lake, Miss.</u> (Address)	0-25 Surface clay	25	
(2) Location: <u>1/4</u> , <u>1/4</u> , Sec. <u>T 1 R 9</u> , <u>5</u> miles <u>N.W.</u> , of <u>Horn Lake</u> , (distance) (direction) (Nearest Town)	25-33 Red sand	8	
(3) Topography: <u>Hilly</u> (Hilly) (Flat) (Level)	33-90 Sand & gravel	57	
(4) Purpose of Well: <u>Domestic</u> (Domestic Irrigation Municipal, Industrial, Other)	90-120 Fine sand	30	
Information upon completion of well:	120-198 Sticky blue clay	78	
(1) Diameter <u>3</u> inches.	198-240 Fine sand, clay	42	
(2) Total Depth <u>368</u> feet.	240-307 Sticky blue ^{strks} clay	67	
(3) Water Level <u>156</u> feet below top of ground.	307-308 Hard rock	1	
(4) Cased to <u>None</u> , Size _____	308-325 Fine sand	17	
(5) Screen: Size <u>2"</u> , Length <u>8'</u>	325-338 Med. fine sand	13	
(6) Were any formations sealed against pollution? _____ yes, <u>No</u> no.	338-344 Med. sand	6	
If YES depth of formation _____	344-360 Med. coarse sand	16	
Why _____	360-368 Coarse & med. coarse	8	
Drillers Remarks: _____			

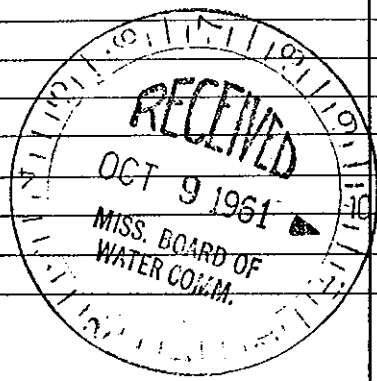

(Use Back Side)

Well No.

Mail this copy to Board of Water Commissioners 429 Miss. St. Jackson, Miss.