

Desoto

Water

Well


A-302 A

A 2002

8-22-61

Date: 8-22, 1961, Driller: H.C. Johnson, County Desoto

(1) Owner of Land:	Description & Color of Materials Sand, Clay, Red Clay, Shell, etc.	Thick- ness Feet	Depth Feet
Jesse Browning (Name) RT 77 (Address)	Red clay	50'	73
(2) Location: 1/4, 1/4, Sec. 14 T. 1 R. 9	Red sand & gravel	10	
miles from station 61 to west (Distance) (Direction) (Nearest Town)	white sand	13	
(3) Topography: X (Hill) (Flat) (Level)	Red gravel		
(4) Purpose of Well: Domestic (Domestic Irrigation Municipal, Industrial, Other)			
Information upon completion of well:			
(1) Diameter 2 inches.	# 0052		
(2) Total Depth 73 feet.			
(3) Water Level 60 feet below top of ground.			
(4) Cased to 68, Size 2			
(5) Screen: Size 1/4, Length 6'			
(6) Were any formations sealed against pollution? yes, no.			
If YES depth of formation			
Why			
Drillers Remarks:			

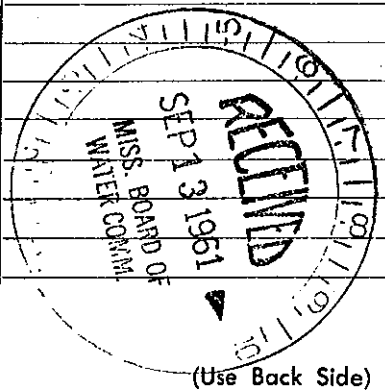

(Use Back Side)

Well No. 7

Retain this copy for your office files.