


Desoto

A Date: 10-20-01 2003, 1916, Driller: H.C. Gardner, County Desoto

(1) Owner of Land:	Description & Color of Materials Sand, Clay, Red Clay, Shell, etc.	Thick-ness Feet	Depth Feet
<u>Gilbert Leath</u> (Name)	Red clay	40	80
<u>1511 Leath Ln</u> (Address)	Shale + <u>limonite</u> (Small)	40	
(2) Location: 1/4, 1/4, Sec. T 19 R 1			
<u>1</u> miles <u>South</u> <u>State</u> <u>lane</u> (distance) (direction) (Nearest Town)			
(3) Topography: <u>301</u> <u>the way + farm</u> (Hill) (Flat) (Level)			
(4) Purpose of Well: <u>Home</u> (Domestic, Irrigation, Municipal, Industrial, Other)			
Information upon completion of well:			
(1) Diameter <u>4</u> inches.			
(2) Total Depth <u>80</u> feet.	#		
(3) Water Level <u>20</u> <u>60</u> feet below top of ground.	0052		
(4) Cased to <u>15</u> , Size <u>16</u>			
(5) Screen: Size <u>11</u> , Length <u>5</u>			
(6) Were any formations sealed against pollution?	<u>Tostee</u>		
_____ yes, _____ no.			
If YES depth of formation _____			
Why _____			
Drillers Remarks: _____			

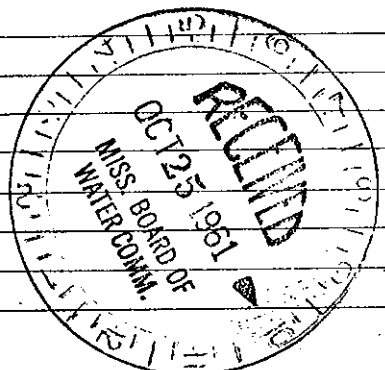

(Use Back Side)

Well No. 15

Retain this copy for your office files.