

B 5
7-8-60

B-300

WATER WELL DRILLERS LOG


CODED

Date: July 8, 19 60 Driller: Deep South Well Co. Coon, DeSoto

(Name)

	Description & Color of Materials Sand, Clay, Red Clay, Shell, etc.	Thick- ness Feet	Depth Feet
(1) Owner of Land: <u>Mrs. J. C. Davis</u> (Name) <u>Horn Lake, Mississippi</u> (Address)	0-15 Surface clay	15	
(2) Location: <u>1/4, 1/4, Sec. 26 T1R8,</u> <u>1 1/2</u> miles <u>N.W.</u> , of <u>Horn Lake,</u> (distance) (direction) (Nearest Town)	15-61 Some gravel sand	46	
(3) Topography: <u>Hilly</u> (Hilly) (Flat) (Level)	<u>61-80 Lignite</u>	19	
(4) Purpose of Well: <u>Domestic</u> (Domestic Irrigation Municipal, Industrial, Other)	<u>80-115 Sandy blue clay</u>	35	
Information upon completion of well:	<u>115-271 Sticky blue clay</u>	156	
	<u>271-287 Fine sand</u>	16	
	<u>287-297 Med. fine sand</u>	10	
	<u>297-316 Blue clay</u>	19	
	<u>316-322 Med. fine sand</u>	6	
(1) Diameter <u>2 1/2</u> inches.	<u>322-332 Med. coarse sand</u>	10	
(2) Total Depth <u>395</u> feet.	<u>332-385 Fine sand</u>	53	
(3) Water Level <u>113</u> feet below top of ground.	<u>385-395 Coarse & med.coarse</u>	10	
(4) Cased to <u>None</u> , Size _____			
(5) Screen: Size <u>1 1/2" - .006 slot</u> , Length <u>10 ft.</u>			
(6) Were any formations sealed against pollution? _____ yes, <input checked="" type="checkbox"/> no.			
If YES depth of formation _____			
Why _____			
Drillers Remarks: <u>None</u>			

CODED

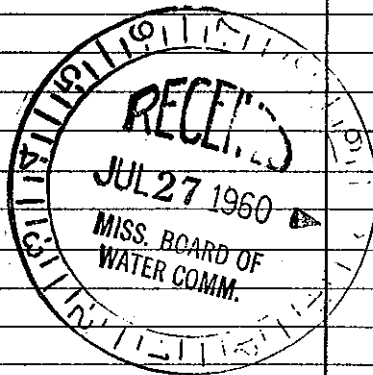

Well No.

(Use Back Side)