

Desoto
 B 36
 8-5-60

MISSISSIPPI BOARD OF WATER COMMISSIONERS

CODED

WATER WELL DRILLERS LOG

Date: August 5, 19 60, Driller: Deep South Well Co. County Desoto
 (Name)

(1) Owner of land: <u>N. H. House, Jr.</u> (Name)	Description & Color of Materials Sand, Clay, Red Clay, Shell, etc.	Thick- ness Feet	Depth Feet
<u>Route 1, Nesbit, Miss.</u> (Address)	<u>0-25 Surface Clay</u>	<u>25</u>	
(2) Location: <u>1/4, NE 1/4, Sec. 2 T2 R2W</u> <u>7</u> miles <u>East</u> , of <u>Horn Lake</u> (distance) (direction) (Nearest Town)	<u>25-97 Sand & Gravel</u>	<u>72</u>	
(3) Topography: <u>Hilly</u> (Hilly) (Flat) (Level)	<u>97-160 Fine Sand</u>	<u>63</u>	
(4) Purpose of Well: <u>Domestic</u> (Domestic Irrigation Municipal, Industrial, Other)	<u>160-185 Med. Sand</u>	<u>25</u>	
	<u>185-197 Med. Coarse Sand</u>	<u>12</u>	

Information upon completion of well:


- (1) Diameter 2 1/2 inches.
- (2) Total Depth 197 feet.
- (3) Water Level 114 feet below top of ground.
- (4) Cased to None, Size _____
- (5) Screen: Size 1 1/8", Length 7 feet.
- (6) Were any formations sealed against pollution?
 _____ yes, No no.

If YES depth of formation _____

Why _____

Drillers Remarks: None

CODED

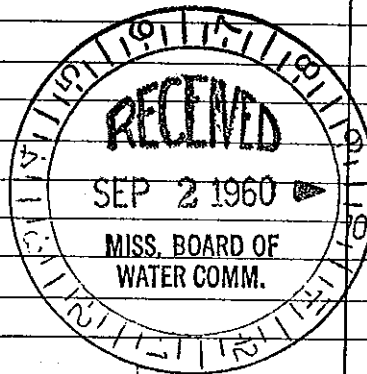

Well No.

(Use Back Side)

Mail this copy to Board of Water Commissioners 429 Miss. St. Jackson, Miss