

B 37

B-301


10-3-60

WATER WELL DRILLERS LOG **CODED**

Date: Oct. 3, 1960, Driller: Deep South Well Co. County DeSoto  
(Name)

(1) Owner of Land: <u>Mrs. Fletcher Davis</u> <small>(Name)</small>	Description & Color of Materials Sand, Clay, Red Clay, Shell, etc.	Thick- ness Feet	Depth Feet
<u>Horn Lake, Miss.</u> <small>(Address)</small>	0-10 Surface clay	10	
(2) Location: <u>1/4, 1/4, Sec. 26 T1R8,</u>	10-35 Clay, fine sand	25	
<u>1</u> miles <u>N.E.</u> , of <u>Horn Lake</u> <small>(distance) (direction) (Nearest Town)</small>	35-40 Lignite	5	
(3) Topography: <u>Flat</u> <small>(Hilly) (Flat) (Level)</small>	40-195 Blue sandy clay	155	
(4) Purpose of Well: <u>Domestic</u> <small>(Domestic Irrigation Municipal, Industrial, Other)</small>	195-196 Red rock	1	
Information upon completion of well:	196-222 Blue clay	26	
(1) Diameter <u>3</u> inches.	222-247 Fine sand	25	
(2) Total Depth <u>321</u> feet.	247-255 Med. sand	8	
(3) Water Level <u>81</u> feet below top of ground.	255-292 Fine sand	37	
(4) Cased to <u>None</u> , Size _____	292-297 Med. sand	5	
(5) Screen: Size <u>2"</u> , Length <u>8 ft</u>	297-307 Med sand-med.	10	
(6) Were any formations sealed against pollution? _____ yes, _____ no.	307-312 Fine sand coarse		
If YES depth of formation _____	312-321 Med. coarse sand	9	
Why _____			
Drillers Remarks: <u>None</u>			

**CODED**

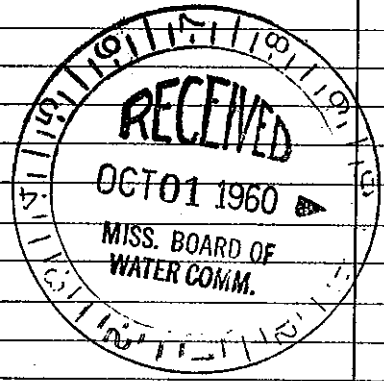

(Use Back Side)

Well No.