

DeSoto MISSISSIPPI BOARD OF WATER COMMISSIONERS

B 38


8-12-60

WATER WELL DRILLERS LOG

B-302
CODED

Date: Aug. 12, 19 60, Driller: Deep South Well Co. County DeSoto
(Name)

	Description & Color of Materials Sand, Clay, Red Clay, Shell, etc.	Thick- ness Feet	Depth Feet
(1) Owner of Land: <u>Floyd Edwards</u> (Name) <u>Horn Lake, Miss.</u> (Address)	0-40 <u>Surface Clay</u>	40	
(2) Location: <u>NW Corner</u> , <u>5 W</u> <u>1/4, 1/4, Sec 32 T1 R 8 W</u> <u>3 miles west</u> , of <u>Horn Lake</u> (distance) (direction) (Nearest Town)	40-74 <u>Sand & Gravel</u>	34	
(3) Topography: <u>Hilly</u> (Hilly) (Flat) (Level)	CODED		
(4) Purpose of Well: <u>Domestic</u> (Domestic Irrigation Municipal, Industrial, Other)			
Information upon completion of well:			
(1) Diameter <u>2</u> inches.			
(2) Total Depth <u>74</u> feet.			
(3) Water Level <u>34</u> feet below top of ground.			
(4) Cased to <u>None</u> , Size _____			
(5) Screen: Size <u>1 1/2"</u> , Length <u>5 ft</u>			
(6) Were any formations sealed against pollution? _____ yes, _____ No no.			
If YES depth of formation _____			
Why _____			
Drillers Remarks: <u>None</u>			

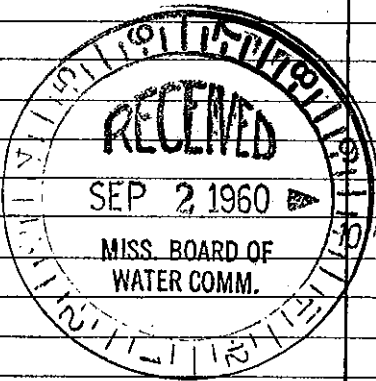

Well No.

(Use Back Side)

Mail this copy to Board of Water Commissioners 429 Miss. St. Jackson, Miss